

CORNER RESTORATION FORM

Township 5N Range 26E Section 27,26,23,22 County MORROW

State OREGON Date 8/21/2019 Number R-17

Corner Designation : CORNER SECTION OF 27,26,23,22

Previous Renewals ORIGINAL SOURCE OF CORNER

ORIGINAL CORNER WAS SET BY DAVID, THOMOPSON, AND
 PENGRA IN 1869 UNDER GLO CONTRACT #131, WHICH WAS A
 POST IN A MOUND OF EARTH, WITH CHARRED STAKE WITH PITS
 AS PER INSTRUCTIONS


Accessories Found:

FOUND 3 1/2" BRASS CAP BLM W.C. IN MOUND OF STONE
AND CARSONITE POST MARK 33.8 (1975) MONUMENT IS
SLIGHTLY LEANING NORTHWEST

- Condition Report Only
- Not Found
- Renewed
- Surveyed In
- Referenced

MONUMENT DETAIL

- Found
- Set

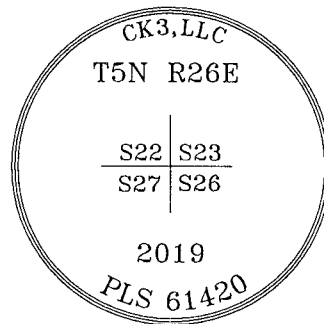

Monument & Accessories Set (Procedure and Description)

SET 3" ALUMINUM MONUMENT ON 5/8" X 10", OVER FOUND 1 1/4" IRON PIPE W/BRASS WASHER AND SCREW.
SET CAP IN CONCRETE FLUSH WITH ROAD GRADE.

SET P.K. NAIL AND 1 1/2" STEEL WASHER IN RR. TIE FENCE POST, S36°33'W 35.30 FT.

SET P.K. NAIL AND 1 1/2" STEEL WASHER IN RR. TIE FENCE POST, S44°57'E 40.21 FT.

FOUND TOP BOLT OF IRRAGATION VALVE, N76°13'E 36.70 FT.

<p style="text-align: center;"><u>Sketch of Monument, Accessories and General Area</u></p>	<p style="text-align: center;">Surveyor's Seal</p> <div style="border: 1px solid black; padding: 5px; text-align: center;"> <p>REGISTERED PROFESSIONAL LAND SURVEYOR</p> <p><i>Lance Clark King</i></p> <p>OREGON MAY 10, 2011 LANCE CLARK KING 61420</p> </div> <p style="text-align: center;">RENEWS: 6/30/2021</p> <p>Agency: CK3, LLC 945 W. ORCHARD HERMISTON OREGON 97838 OFFICE: 541-567-2345 FAX: 541-567-2305 WEB: CK3LLC.NET Field Book # 0-327</p> <p style="text-align: center;">COUNTY SURVEYOR RECORDING INFO</p> <p>Received <u>10-17-2019</u></p> <p>Filed by: <u>S.K.H.</u></p> <p>Survey No. _____</p> <p>Drawing No. <u>T5N R26E</u></p> <p>Index No. <u>R-17</u></p>
--	--