

CORNER RESTORATION FORM

Township 5N Range 26E Section 27,26 County MORROW

State OREGON Date 8/21/2019 Number T-17

Corner Designation : 1/4 CORNER SEC. 27,26

- Condition Report Only
- Not Found
- Renewed
- Surveyed In
- Referenced

Previous Renewals ORIGINAL SOURCE OF CORNER


ORIGINAL CORNER WAS SET BY DAVID, THOMPSON, AND
PENGRA IN 1869 UNDER GLO CONTRACT #131, WHICH WAS A
POST IN A MOUND OF EARTH, WITH CHARRED STAKE WITH PITS
AS PER INSTRUCTIONS

MONUMENT DETAIL

Found Set

Accessories Found:

NONE

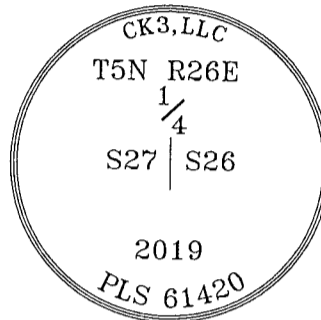

Monument & Accessories Set (Procedure and Description)

- SET 3" ALUMINUM CAP ON 5/8" X 3" REBAR, OVER FOUND 5/8" REBAR IN CONCRETE FLUSH WITH ROAD GRADE.
- SET P.K. NAIL AND 1 1/2" STEEL WASHER IN RR. TIE FENCE POST, N36°6'E 44.03 FT.
- SET 5/8" REBAR AND GREEN CK3 CONTROL CAP NEXT TO PHONE BOX, S16°37'W 51.98 FT.
- SET 5/8" REBAR AND CK3 GREEN CONTROL CAP NEXT TO FOUND STEEL FENCE POST, N5°54'W 219.03 FT.
- FOUND 5/8" REBAR WITH NO CAP, N89°48'E 19.92 FT.
- FOUND 5/8" REBAR WITH NO CAP NEXT RR. TIE FENCE POST, N88°17'E 29.52 FT.

Sketch of Monument, Accessories and General Area

Surveyor's Seal

**REGISTERED
PROFESSIONAL
LAND SURVEYOR**

Lance Clark King

**OREGON
MAY 10, 2011
LANCE CLARK KING
61420**

RENEWS: 6/30/2021

Agency:
 CK3, LLC
 945 W. ORCHARD
 HERMISTON OREGON 97838
 OFFICE: 541-567-2345
 FAX: 541-567-2305
 WEB: CK3LLC.NET
 Field Book # 0-327

**COUNTY SURVEYOR
RECORDING INFO**

Received 10-17-2019

Filed by: S.K.H.

Survey No. _____

Drawing No. T5N R26E

Index No. T-17