

CERTIFIED RECORD OF LAND CORNER MONUMENTATION / RESTORATION


T.5N., R.27E., INDEX V-9

History of original corner establishment:

This corner was originally established by Timothy Davenport under G.L.O. contract No. 101, dated August 5, 1861. Survey General notes state:

Set post corner to Secs 32, 33, 28 & 29, made mound and drove charred stake as per instructions.

Donald Staebler set a brass disc in 1972 as shown on Umatilla County Map of Survey H-106-B.

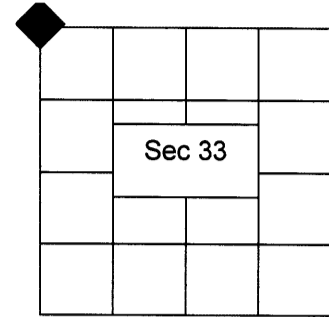

Description of corner evidence found:

No evidence of this corner is found. Set monument at double proportionate measure.

Description of monument and accessories I establish to perpetuate the original location of this corner:

At proportionate position determined by survey, Set a 2-1/2" x 30" aluminum pipe monument with 3" dia. cap stamped as shown in the DIAGRAM, 18" below the ground surface, from which:

- A 5/8" rebar pin bears N55°32'57"W, 24.59 ft.
- A 5/8" rebar pin with 1 groove filed on the top, bears N44°13'42"E, 20.12 ft.
- A 5/8" rebar pin with 2 grooves filed on the top, bears S38°11'24"E, 30.15 ft.
- A 5/8" rebar pin with 3 grooves filed on the top, bears S31°56'44"W, 53.18 ft.

Placed an orange plastic cap marked "FS&E Survey Marker" on all rebar pins. Set a green steel "T" post with white top 1.5 ft. north of monument.

DIAGRAM

T5N R27E
S29 | S28

S32 | S33
2015
PLS 49865

Measurements to accessories taken with: Topcon Hyper II GPS (RTK)

I hereby certify that the above corner point was perpetuated as shown hereon on July 30, 2015

Witness: D. Mitchell Ferguson, LSIT
David Herburger

Office of County Surveyor County of Morrow
State of Oregon. I hereby certify that the within instrument was filed in this office
for record on the 13th day of January, 2016

Stephen K. Haddock by Stephen K. Haddock
County Surveyor Deputy

Refer to Map of Survey # 2016-1752D

