

CERTIFIED RECORD OF LAND CORNER MONUMENTATION

History of original corner establishment:

Index: N-3

1/4 Corner Sections 18 and 19, T.5S., R.26E, W.M.

Original corner was set by Thatcher under Contract No. 325 dated 1879.  
 His record reads:  
 Set a basalt stone 12x12x6 in ground for 1/4 corner with mound of stone.  
 Beginning at the NW corner of Section 19, thence S 89°44'E, 2.4 Chains, a 30" pine line tree.  
 39.9 chains, set 13x13x9" stone in mound.  
 74.2 chains, a road. 79.95 chains, the corner.

DIAGRAM	
T59	R26E
1	S18
4	S19
	1995
	PLS 852


Description of corner evidence found:

Found a stone 13x13x9" with one other stone firmly embedded in the ground. There were no other stones of record size within 200' of the stone. There was no apparent marking on the stone. A 4' pine line tree was found 2463' westerly and a road was found 2241' easterly. A mound of stone with a stone of record size was found 411' east of the road.

Description of monument and accessories I established to perpetuate the original location of this corner:

At the location of the stone, I set a 2 1/2" x 30" aluminum pipe with a 2 1/2" aluminum cap. I buried the stone along side of the pipe. I stamped the cap as shown in the diagram above. I set the following reference objects:  
 A 1/2x24" rebar with a 2" aluminum cap stamped OR LS 852 and WA LS 13922 bears N45°W, 40.0'. A 1/2x24" rebar with a 2" aluminum cap stamped OR LS 852 and WA LS 13922 bears N45°E, 40.0'. A 5/8x24" rebar with a 2" aluminum cap stamped OR LS 852 and WA LS 13922 bears S45°W, 40.0'. A 5/8x20" rebar with a 2" aluminum cap stamped OR LS 852 and WA LS 13922 bears S45°E, 40.0'.

This work was done February 20, 1995.

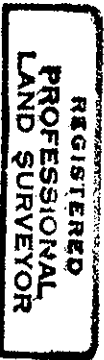

*David L. Haddock*



Office of \_\_\_\_\_ County of Marion  
 State of \_\_\_\_\_, I hereby certify that the within instrument was filed  
 in this office for record on the 7 day of Mar, 1995.  
 \_\_\_\_\_ by \_\_\_\_\_  
 ( COUNTY OFFICIAL ) ( DEPUTY )