


R26E

History of original corner establishment:
E.A. Thatcher under G.L.O. contract number 325,
dated June 4, 1879, set a stone 13"X 13"X 5"
and raised a stone mound at the corner.

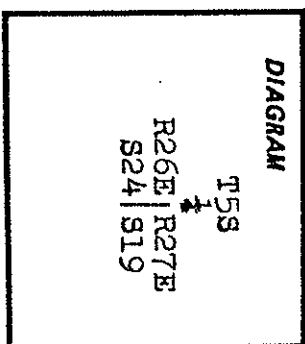

Description of corner evidence found:

I found a stone 12"X 12"X 7" marked: $\frac{1}{4}$; in a small stone mound.

Description of monument and accessories I established to perpetuate the original location of this corner:

At the original corner point I set a 2 $\frac{1}{2}$ "X 30" alum. pipe with a 3" alum. cap containing a magnet and marked:

T58

R26E R27E
S24 S19
PLS 1832
1986

I buried the original stone alongside and built a stone mound around the monument.

From the corner:


- A Ponderosa Pine, 12" dia., N230E, 70.2 ft. marked: $\frac{1}{4}$ S19 BT
- A Ponderosa Pine, 11" dia., N44 3/4°W, 23.6 ft. marked: $\frac{1}{4}$ S24 BT

BTs have blaze and a 6" stripe painted red, a BT tag, an "Attention" sign and an alum. "PLS 1832" washer nailed to the bottom of the blaze. There is a 6' steel fence post with an "Attention" sign within 5' of the corner.

Measured to center of BTs using steel tape and staff compass. Magnetic declination set at 190°E.

June 29, 1986

Office of: Sukueyak County of MORRIS
 State of Oregon I hereby certify that the within instrument was filed in this office
 for record on the 21 day of July, 1986 by Michaelle Doka
 (COUNTY OFFICIAL) (DEPUTY)

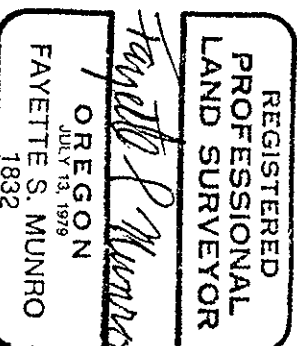

Form R6-7100-57 (9/71)

Morrow County Surveyor

Date 7/21/86

Rec'd By MLD

No. 824-K