

CERTIFIED RECORD OF LAND CORNER MONUMENTATION

History of original corner establishment:

Index: R-3

Quarter corner sections 19 and 30, T.5S., R.26E, W.M.

Original corner was set by Thatcher under Contract No. 325 dated 1879.

The record:

From the west corner between sections 19 and 30	
from which:	
A 30" Fir line tree lies 6.6 chains northerly.	
Thence S89°39'E on the true between sections 19 and 30.	
3.8 ch. a spring. 18.20 ch. a 30" Fir line tree.	
40.11 ch. set 13x11x5 stone with mound. 40.96 ch.	
Rock Creek. 54.10 ch. cabin 5 ch. north. 80.11 ch.	
the corner of sections 19, 20, 29, and 30.	


Description of corner evidence found:

At 250' a wet area. At 1201' numerous large fir stumps. Line tree not identified. 2647' falls east of Rock Creek. Searched area west of Rock Creek and found no evidence of the corner. The location which fit the call from the creek was steep and rocky. At 3571 old log structure lies 554' north of line. I assume this is not the cabin of record. 5239.82' the corner to sections 19, 20, 29, and 30.


Description of monument and accessories I established to perpetuate the original location of this corner:

At a point on line between the NE and NW corners of section 30, and 56' westerly of the thread of Rock Creek, I set a 2 1/2" Brass cap stamped as shown in the diagram above. The Brass cap is cemented into the stone with a cow magnet beneath it. I set the following new witness trees:
 A 8" dbh Ponderosa Pine bears N38°W, 82.8', scribed 1/4S19BT.
 A 23" dbh Ponderosa Pine bears N10°E, 43.3', scribed 1/4S19BT.
 A 12" dbh Ponderosa Pine bears S19°W, 71.2', scribed 1/4S30BT.
 A 12" dbh Ponderosa Pine bears S29°E, 25.9', scribed 1/4S30BT.
 A brass washer stamped ORLS 852 and WAL513922 is nailed between the letters B and T on each new tree.
 A Bearing Tree tag was nailed to the original tree.

This work was done March 1, 1995.

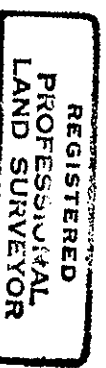

David L. Haddock

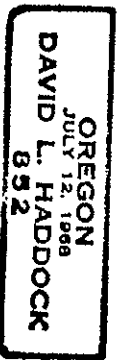

 State of _____, I hereby certify that the within instrument was filed
 in this office for record on the 7 day of MAR, 1995.
 _____ by _____
 (COUNTY OFFICIAL) (DEPUTY)