

CERTIFIED RECORD OF LAND CORNER MONUMENTATION

R26E

T-25

DIAGRAM

R	T55	R
2	1/4	2
6	S25 1/4 S30	7
E		E

History of original corner establishment:

The original corner was established in 1879 by Everett A. Thatcher as follows:

Set stone 15"x13"x5" for 1/4 section corner. Raised mound of stone at corner.

Description of corner evidence found:

A thorough search did not reveal any trace of the original corner.

Description of monument and accessories | established to perpetuate the original location of this corner:

At the proportionate point I set a 2"x32" galvanized iron pipe, with a 2 1/2" brass cap attached, 20" into the ground and built a mound of stone around pipe. The brass cap is marked:


From which:

A 18" ponderosa pine bears N55°W, 20.3 ft., scribed			
1/4 S25 BT" on a single blaze.			
A 9" ponderosa pine bears N89°E, 78.3 ft., scribed			
1/4 S30 BT" on a single blaze.			
54-3 and 54-4 signs were placed on new bearing trees			
Compass Declination: 20°E			

I hereby certify the above corner location was perpetuated as hereon described on October 19, 1983.

Witness: Susan E. Newstetter

County Surveyor County of Morrow
 Office of Oregon I hereby certify that the within instrument was filed in this office
 for record on the day of 19.....
 (COUNTY OFFICIAL) by (DEPUTY)

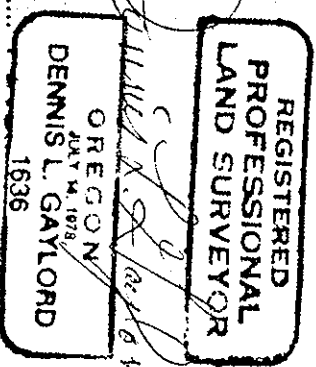

Form R6-7100-57 (9/71)

RECEIVED BY

Morrow County Surveyor

Date 12-5-83

Rec'd By MLD

No. 648-14