


**CERTIFIED RECORD OF LAND CORNER MONUMENTATION**

R 26 E

V-25

**History of original corner establishment:**  
 The original corner was established in 1879 by Everett A. Thatcher as follows:  
 Set stone 32"x12"x6" for corner to sections 25, 36, 30, and 31. Raised stone mound at corner.

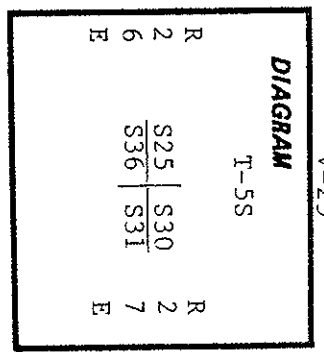

**Description of corner evidence found:**  
 A ring of stones around the corner point. The original corner stone was found out of position lying on the ground several feet south. The corner stone is marked "  $\frac{26}{5}$  " on the west face and "  $\frac{27}{5}$  " on the east face. An original unrecorded bearing tree, a live 23" ponderosa pine <sup>27</sup>bears N44°E, 22.7 ft. with scribes visible on a nearly healed upper blaze and the lower blaze is healed shut.


**Description of monument and accessories | established to perpetuate the original location of this corner:**

In the center of the stone ring I set a 2"x32" galvanized iron pipe with a 2 1/2" brass cap attached, 16" into the ground. Placed corner stone along north side of pipe and built mound of stone around pipe. The brass cap is marked:

R		R
2	S25   S30	2
6	S36   S31	7
E		E

PLS 1636  
1983

**From which:**  
 A 13" Douglas-fir bears N51°W, 17.8 ft., scribed "T55 R26E S25 BT"  
 on a single blaze.  
 A 12" Douglas-fir bears S71°W, 27.4 ft., scribed "T55 R26E S36 BT"  
 on a single blaze.  
 A 9" Douglas-fir bears, S56°E, 30.4 ft., scribed "T55 R27E S31 BT"  
 on a single blaze.  
 54-3 and 54-4 signs were placed on all bearing trees.  
 Compass Declination: 20° East

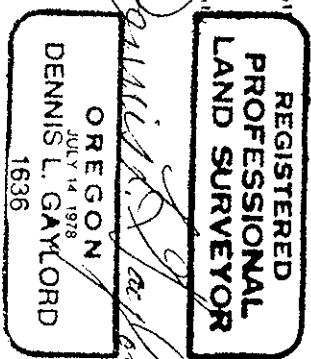

I hereby certify the above corner location was perpetuated as hereon described on October 20, 1983.  
 Witness: Susan E. Newstetter

Office of.....County Surveyor.....County of.....Morrow  
 State of.....Oregon....., I hereby certify that the within instrument was filed in this office  
 for record on the.....day of....., 19.....  
 (COUNTY OFFICIAL) by (DEPUTY)

Form R6-7100-57 (9/71)  
 REC. NOV BY  
 Morrow County Surveyor  
 Date 12-5-83  
 Rec'd By MLD  
 No. 650-K