


History of original corner establishment:

The original corner was established in 1879 by Everett A. Thatcher as follows:

Set stone 12"x8"x8" for standard corner to townships 5 and 6 south, Ranges 26 and 27 east, Willamette Meridian, Oregon.

From which:

A pine 14" in diameter bears N10°E, 26 lks. distance.
 A pine 12" in diameter bears N26°W, 40 lks. distance.

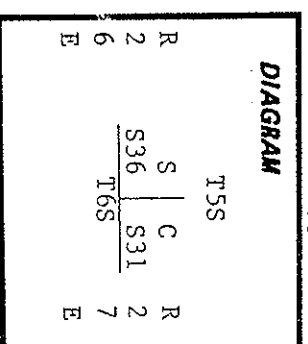

Description of corner evidence found:

Original 12", now 19", ponderosa pine with previously opened upper blaze with scribes "R26E" visible and healed lower blaze bears N26°W, 26.4 ft. from the corner. Note:

A 12" fir is on line between corner and BT.

Description of monument and accessories | established to perpetuate the original location of this corner:

By reference to the only remaining original bearing tree I set a 2"x32" galvanized iron pipe, with a 2 1/2" brass cap attached, 26" into the ground and raised a mound of stones around pipe. Brass cap is marked:

From which:

	R	T55	R
	2	S C	2
	6	S36 S31	7
	E	T6S	E

PLS 1636
1983


54-3 and 54-4 signs were placed on bearing trees.

Compass Declination: 20°E

I hereby certify the above corner location was perpetuated as hereon described on September 27, 1983.

Witness: Susan E. Newstetter

Dennis L. Gaylord

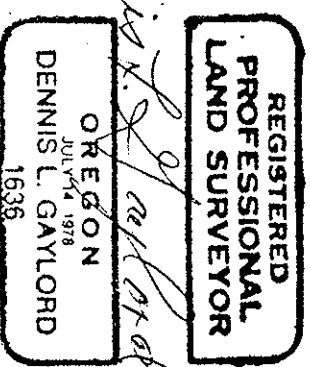

Office of..... County of..... County of.....
 State of..... Oregon..... I hereby certify that the within instrument was filed in this office
 for record on the..... day of....., 19.....
 (COUNTY OFFICIAL) (DEPUTY)

Form R6-7100-57 (9/71) RECEIVED BY
 MOTTOW County Surveyor
 Date 12-5-83
 Rec'd By MLO
 No. 651-K
 GPO-798-276