

OREGON CORNER RESTORATION FORM

COUNTY: Morrow DATE: 04/20/04

CORNER DESIGNATION: A-5, The Northeast Closing Corner of Section 6, Township 5 South, Range 27 East, W.M., Morrow County, Oregon.

PREVIOUS RENEWALS/SURVEYS ETC.: Corner originally established by Edward W. Sanderson under Contract No. 417, dated August 24, 1881. Record states: Set basalt stone 18 x 10 x 9 ins. 12 ins. in ground for Cor. to Sees. 5 & 6 marked with 5 notches on E. 1 notch on W. and 6 notches on S. edges. Raised mound of stone alongside.

MONUMENT AND ACCESSORIES FOUND: Found a rock mound overgrown with grass and remains of old down fences extending South and East. There is a fence line visible some distance to the West. Searched for the Standard Corner 1.05 chains West and found no evidence of it. All stones in this area are small 2 to 6" diced rock. Found no stones near record stone size. I accepted the overgrown rock mound as best remaining evidence of the original corner location, and reestablished the corner point on the West side of the rock mound.

MONUMENT MARKING DETAIL:

T4S R27E
S32
S6 | S5
T5S R27E
CC
2004
PLS 1106

MONUMENT SET: At the West edge of overgrown, rock mound, set a 5/8" x 24" rebar with 2" aluminum cap marked as shown in "Monument Marking Detail". The rebar is driven 20" in the rocky ground and surrounded with stone.

New Accessories:

A silver "deep-1" magnet buried 12" in ground bears N 08° E, 46.4 feet.
A purple "deep-1" magnet buried 12" in ground bears S 57° E, 48.0 feet.
A blue "deep-1" magnet buried 12" in ground bears S 14° W, 58.6 feet.
An "orange "deep-1" magnet buried 12" in ground bears N 64° W, 38.8 feet.
Buried "bearing object signs" with each of the "deep-1" magnets.

LOCATION AND COMMENTS: Corner is located on a bare, rocky ridge top.


FIRM: William R. Wells, PLS

P.O. Box 1696
Pendleton, OR 97801

COMPASS DECLINATION: 18° East Surveyor's Seal

Witnesses: Jason Wells, LSIT
Marc Hammersla

ISS27A5

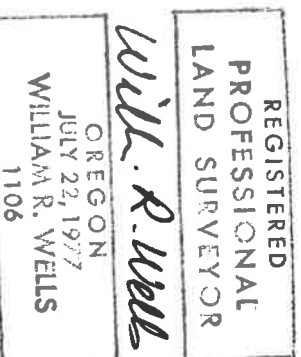

RECEIVED BY
Morrow County Surveyor

renews 6-30-06

Date: 1-08-05
Recd By: RVA
No.: D-1409-A
Folder No.: _____