

OREGON CORNER RESTORATION FORM

COUNTY: Morrow DATE: 04/20/04

CORNER DESIGNATION: E-5, The Northeast Corner of Section 8, Township 5 South, Range 27 East, W.M., Morrow County, Oregon.

PREVIOUS RENEWALS/SURVEYS ETC.: Corner originally established by Edward W. Sanderson under Contract No. 417, dated August 24, 1881. Record states: Set basalt stone 16 x 9 x 8 ins. 11 ins. in ground for Cor. to Secs. 5, 6, 7 and 8, marked with 5 notches on S. and E. edges, on summit of rocky, mountainous ridge, 800 feet above sec. cor., raised mound of stone alongside.

MONUMENT AND ACCESSORIES FOUND: Found ancient rock crib with old fence remains extending East and what appears to be an old farm line extending North. I excavated the rock crib and found no stones of record size—most stones are small—largest stone found was 14x8x6. I accept this ancient rock crib as the best remaining evidence of the original corner location.

MONUMENT MARKING DETAIL:

T5S R27E
S6 | S5
S7 | S8
2004
PLS 1106

MONUMENT SET: At the Southwest corner of the ancient rock crib, set a 5/8" x 24" rebar with a 2" aluminum cap, marked as shown in "Monument Marking Detail". The rebar is driven 22" in the ground.

New Accessories:

- A 5/8" x 24" rebar with a 1 1/4" yellow plastic cap stamped "OR PLS 1106, WA PLS 17372" bears N 26° E, 39.3 feet.
- A 5/8" x 24" rebar with a 1 1/4" yellow plastic cap stamped "OR PLS 1106, WA PLS 17372" bears S 32° E, 43.9 feet.
- A 5/8" x 24" rebar with a 1 1/4" yellow plastic cap stamped "OR PLS 1106, WA PLS 17372" bears S 46° W, 56.0 feet.
- A 5/8" x 24" rebar with a 1 1/4" yellow plastic cap stamped "OR PLS 1106, WA PLS 17372" bears N 60° W, 38.7 feet.

Wired "bearing object tags to each of the rebar accessories.
Nailed "witness" sign to rock crib post North of corner monument.

LOCATION AND COMMENTS:

Corner is at Southwest corner of old rock crib, on East facing slope.

FIRM: William R. Wells, PLS
P.O. Box 1696
Pendleton, OR 97801

COMPASS DECLINATION: 18° East Surveyor's Seal


Witnesses: Jason Wells, LSIT
Marc Hammersla
VSS27E5

RECEIVED BY
Morrow County Surveyor

Date: 1-68-05
Rec'd By: RUM
No.: D-1409-M
Folder No.: _____



Will. R. Wells

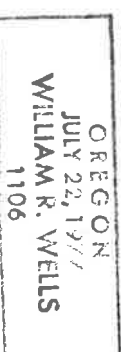

Renews 6-30-06