

CERTIFIED RECORD OF LAND CORNER MONUMENTATION

INDEX No. J-17

History of original corner establishment:

DIAGRAM

This corner was originally established by Edward W. Sanderson in 1881-82 under GLO Contract Number 417. Surveyor General Field Notes state:

T55	R27E
S10	S11
S15	S14
1992	
PLS	848

A point 200 ft. above ravine set sandstone 18x7x6 ins. 12 ins. in ground for Cor. to Secs. 10,11,14 and 15, marked with 4 notches on S and 2 notches on E. edges from which

A Pine 12 in. dia. bears N35°E, 58 lks. dist. marked T5S R27E Sec 11 BT
 A Pine 14 in. dia. bears N55°W, 41 lks. dist. marked T5S R27E Sec 10 BT
 A Pine 16 in. dia. bears S35°W, 19 lks. dist. marked T5S R27E Sec 15 BT
 A Pine 18 in. dia. bears S25°E, 12 lks. dist. marked T5S R27E Sec 14 BT

Description of Corner Evidence Found:

Found stone 17x9x5 ins. with 4 grooves, lying loose on the ground.

Ponderosa Pine stump, 16" dia., with some scribing visible, bears N54°05'W, 34.20 ft. (Rec: N55°W, 27.06 ft.)

Ponderosa Pine snag, 28" dia, approx. 25' high, with full scribing visible on open upper blaze, bears N45°54'E, 6.80 ft., (Rec: N35°E, 38.28 ft.)

Ponderosa Pine, 40" dia., down, with faint scribing visible, bears S23°46'E, 26.80 ft. (Rec: S25°E, 7.92 ft.)


Ponderosa Pine, 20" dia., staub, scribing on upper blaze, bears S27°58'W, 12.60 ft., (Rec: S35°W, 12.54 ft.)

Description of monument and accessories I established to perpetuate the original location of this corner:

Set 2-1/2"x30" aluminum pipe with 3-1/2" aluminum cap, stamped as shown on the DIAGRAM, 26" in the ground and buried stone on north side of monument. From which:

Ponderosa Pine, 8" dia., bears N54°15'W, 26.5 ft., scribed:T5S R27E S10 BT
 Ponderosa Pine, 8" dia., bears N11°15'E, 43.7 ft., scribed:T5S R27E S11 BT
 Ponderosa Pine, 10" dia., bears S58°30'E, 14.9 ft., scribed:T5S R27E S14 BT
 Ponderosa Pine, 20" dia., bears S32°45'W,123.1 ft., scribed:T5S R27E S25 BT

Measurements to BT's taken with a magnetic compass, declination 20° East, and a nylon clad steel tape. Set steel fence post with Land Survey Monument (54-9) sign 4' north of the monument. Nailed a brass washer stamped PLS 848 on blaze above BT scribe as taken this survey. Nailed Bearing Tree (54-3) signs above blaze and Land Survey Monument (54-9) signs on back of each tree as required. Painted a 6" red band above Bearing Trees signs and painted blaze red.

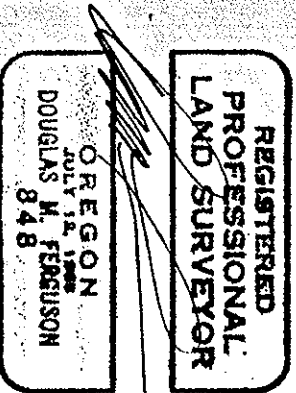

This work was performed by:
 Douglas M. Ferguson PLS 848
 Witnessed by: D. Mitchell Ferguson
 and Rick Sau1
 April 22, 1992
 Refer to Morrow Co. Survey No.: C-937-E

Office of _____ County of MORROW
 State of OR I hereby certify that the within instrument was
 filed in this office for record on the 9 day of July, 1992
 by DS
 (COUNTY OFFICIAL) (DEPUTY)