

CERTIFIED RECORD OF LAND CORNER MONUMENTATION

INDEX No. J-21
 History of original corner establishment:

DIAGRAM

This corner was originally established by Edward W. Sanderson in 1881-82 under GLO Contract Number 417. Surveyor General Field Notes state:

T55	R27E
S11	S12
S14	S13
1992	
PLS	848

At point 50 ft. above branch, set sandstone 14x8x7 ins. 9 ins. in ground for Cor. to Secs. 11, 12, 13 and 14 marked with 4 notches on S and 1 notch on E. edges.

from which				
A Pine 20 in. dia.	bears S34°E,	56 lks. dist.	T55 R27E	Sec 13 BT
A Pine 24 in. dia.	bears S25°W,	109 lks. dist.	T55 R27E	Sec 14 BT
A Pine 38 in. dia.	bears N62°W,	25 lks. dist.	T55 R27E	Sec 11 BT
A Pine 12 in. dia.	bears N43°E,	46 lks. dist.	T55 R27E	Sec 12 BT

Description of Corner Evidence Found:

Found small stone lying loose, however it has no marks and is not the corner stone. Re-established the corner's position from the bearing trees recovered.

Ponderosa pine stump, with scribing visible, bears N43°E, 26.76 ft., (Rec: N43°E, 30.36 ft.)

Ponderosa pine, 28" dia, with scribing visible, bears S34°E, 35.57 ft., (Rec: S34°E, 36.96 ft.)


Ponderosa pine, 36" dia., with scribing visible, bears S24°30'W, 72.45 ft. (Rec: S25°W, 71.94 ft.)

Description of monument and accessories I established to perpetuate the original location of this corner:

At the best fit position determined from the recovered bearing trees I set 2-1/2"x30" aluminum pipe with 3-1/2" aluminum cap, stamped as shown on the DIAGRAM, 28" in the ground.
 From which:

White Fir,	10" dia.,	bears N46°15'W,	19.8 ft.,	scribed:T55 R27E	S11 BT
Ponderosa pine,	18" dia.,	bears N53°30'E,	49.9 ft.,	scribed:T55 R27E	S12 BT
Ponderosa pine,	26" dia.,	bears S34°00'E,	36.9 ft.,	scribed:T55 R27E	S13 BT

Measurements to BT's taken with a magnetic compass, declination 20° East, and a nylon clad steel tape. Set steel fence post with Land Survey Monument (54-9) sign 5' east and west of the monument. Nailed a brass washer stamped PLS 848 on blaze above BT scribe as taken this survey. Nailed Bearing Tree (54-3) signs above blaze and Land Survey Monument (54-9) signs on back of each tree as required. Painted a 6" red band above Bearing Trees signs and painted blaze red.

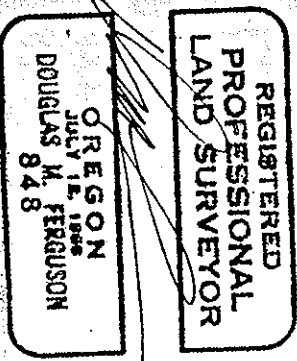

This work was performed by:
 Douglas M. Ferguson PLS 848
 Witnessed by: D. Mitchell Ferguson
 and Rick Saul
 April 23, 1992
 Refer to Morrow Co. Survey No.: C-937-E

Office of OR County of MORROW
 State of OR I hereby certify that the within instrument was
 filed in this office for record on the 9 day of July, 1992
 by SB
 (COUNTY OFFICIAL) (DEPUTY)