

CERTIFIED RECORD OF LAND CORNER MONUMENTATION

INDEX No. L-19

History of original corner establishment:

None. Corner established this survey.

DIAGRAM

T55 R27E
C 1/4

S 14
1992

PLS 848

Description of Corner Evidence Found:

None. Corner established this survey.

Description of monument and accessories I established to perpetuate the original location of this corner:

Set 2-1/2"x30" aluminum pipe with 3-1/2" aluminum cap, stamped as shown on the DIAGRAM, 26" in the ground.

From which:

Western Larch,	10" dia.,	bears N38°57'W,	70.1 ft.,	scribed: C1/4 S14 BT
Douglas Fir,	12" dia.,	bears N33°53'E,	38.0 ft.,	scribed: C1/4 S14 BT
Douglas Fir,	20" dia.,	bears S30°30'E,	89.5 ft.,	scribed: C1/4 S14 BT
White Fir,	18" dia.,	bears S28°30'W,	81.8 ft.,	scribed: C1/4 S14 BT

Measurements to BT's taken with an Electronic Tacheometer with bearings based on the survey control network. Set steel fence post with Land Survey Monument (54-9) and Property Boundary (54-2) signs 5' north and west of the monument. Nailed a brass washer stamped PLS 848 on blaze above BT scribe as taken this survey. Nailed Bearing Tree (54-3) signs above blaze and Land Survey Monument (54-9) signs on back of each tree as required. Painted a 6" red band above Bearing Trees signs and painted blaze red.

This work was performed by:


Douglas M. Ferguson PLS 848

Witnessed by: D. Mitchell Ferguson

and Rick Saul

April 23, 1992

Refer to Morrow Co. Survey No.: C-937-E

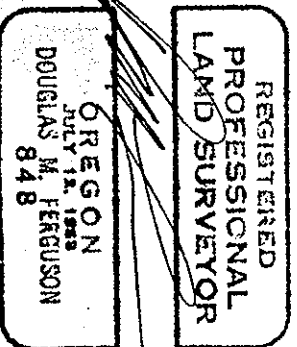


Office of OR I hereby certify that the within instrument was filed in this office for record on the 9 day of July, 1992

(COUNTY OFFICIAL)

(DEPUTY)

County of MORROW