

CERTIFIED RECORD OF LAND CORNER MONUMENTATION

INDEX No. ~M-17

History of original corner establishment:

This line tree was originally established by Edward W. Sanderson in 1881-82 under GLO Contract Number 417. Surveyor General Field Notes state:

20.91 A Pine 24 in. dia on line

DIAGRAM
T55 R27E
WC
Line Tree
S15 E1/4 S14
1992
PLS 848

Description of Corner Evidence Found:


Found a Ponderosa Pine stump, 30" dia x 60" high with an old fence wire on east face and axe and blaze marks on west face. I accept this as the remains of the line tree. Tied into the survey scheme and it fits well.

Description of monument and accessories I established to perpetuate the original location of this corner:

Set 2-1/2"x30" aluminum pipe with 3-1/2" aluminum cap, stamped as shown on the DIAGRAM, 27" in the ground, on line, 10.0 ft. north as the witness corner for the line tree. The following bearing trees are to the line tree.

Western Larch, 14" dia., bears N21°30'E, 47.8 ft., scribed: LT S14 BT
Ponderosa Pine, 12" dia., bears N74°45'W, 16.2 ft., scribed: LT S15 BT

Measurements to BT's taken with a magnetic compass, declination 20° East, and a nylon clad steel tape. Set steel fence post with Land Survey Monument (54-9) and Property Boundary (54-2) signs 5' north and south of the monument. Nailed a brass washer stamped PLS 848 on blaze above BT scribe as taken this survey. Nailed Bearing Tree (54-3) signs above blaze and Land Survey Monument (54-9) signs on back of each tree as required. Painted a 6" red band above Bearing Trees signs and painted blaze red. Set

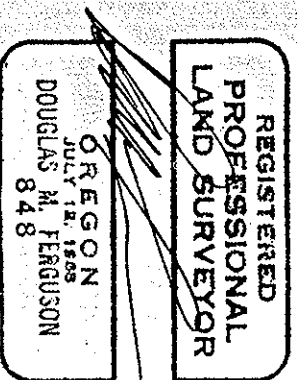

This work was performed by:
Douglas M. Ferguson PLS 848
Witnessed by: D. Mitchell Ferguson
and Rick Saul
April 22, 1992
Refer to Morrow Co. Survey No.: C-937-E

Office of McKraw County of Morrow
State of OR I hereby certify that the within instrument was
filed in this office for record on the 9 day of July, 1992
by SR
(COUNTY OFFICIAL) (DEPUTY)