

CERTIFIED RECORD OF LAND CORNER MONUMENTATION

INDEX No. N-15

History of original corner establishment:

DIAGRAM

This corner was originally established by Edward W. Sanderson in 1881-82 under GLO Contract Number 417. Surveyor General Field Notes state:

T5S R27E
S15
1/4 _____
S22
1992
PLS 848

Set sandstone 15x7x6 ins. 10 ins. in ground for 1/4 sec cor marked 1/4 on N. face from which

A Fir 12 in dia. bears SOUTH 24 lks. dist. marked 1/4 S BT
A Fir 9 in dia. bears N10°E 23 lks. dist. marked 1/4 S BT

Description of Corner Evidence Found:

Stone is gone. Nothing found.
Douglas Fir, 24" dia, with healed blazes, lower blaze chopped on but not opened, bears SOUTH 15.84 ft. (Rec: South, 15.84 ft.)



Description of monument and accessories I established to perpetuate the original location of this corner:

At the position determined from the remaining original bearing tree I set 2-1/2"x30" aluminum pipe with 3-1/2" aluminum cap, stamped as shown on the DIAGRAM, 22" in the ground and built a mound of earth and stone around the monument.

From which:

Douglas Fir, 8" dia., bears N31°15'W, 150.5 ft., scribed: 1/4 S15 BT
White Fir, 8" dia., bears N31°30'E, 61.7 ft., scribed: 1/4 S15 BT
Douglas Fir, 16" dia., bears S48°30'E, 46.7 ft., scribed: 1/4 S22 BT

Measurements to BT's taken with a magnetic compass, declination 20° East, and a nylon clad steel tape. Set steel fence post with Land Survey Monument (54-9) and Property Boundary (54-2) signs 5' east and west of the monument. Nailed a brass washer stamped PLS 848 on blaze above BT scribe as taken this survey. Nailed Bearing Tree (54-3) signs above blaze and Land Survey Monument (54-9) signs on back of each tree as required. Painted a 6" red band above Bearing Trees signs and painted blaze red.

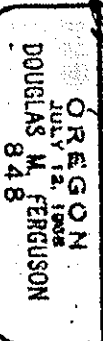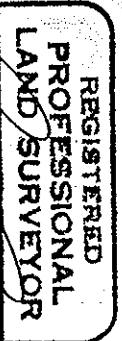

This work was performed by:
Douglas M. Ferguson PLS 848
Witnessed by: D. Mitchell Ferguson
and Rick Sauli
March 27, 1992
Refer to Morrow Co. Survey No.:

Office of _____ County of MORROW
State of OR I hereby certify that the within instrument was
filed in this office for record on the 9 day of JULY, 1992
by SB
(COUNTY OFFICIAL) (DEPUTY)