

CERTIFIED RECORD OF LAND CORNER MONUMENTATION

INDEX No. N-19

History of original corner establishment:

DIAGRAM

This corner was originally established by Edward W. Sanderson in 1881-82 under GLO Contract Number 417. Surveyor General Field Notes state:

T5S R27E

S14

1/4 _____

S23

1992

PLS 848

Set sandstone 24x9x6 ins. 18 ins. in ground for 1/4 sec. cor. marked 1/4 on N. face from which:

A Fir 14 in. dia. bears N15°E, 20 lks. dist. marked 1/4 S BT
A Fir-10 in. dia. bears N80°E, 20 lks. dist. marked 1/4 S BT

Description of Corner Evidence Found:

Conducted a very extensive search and could not locate the stone or bearing trees. There are several stones in the search area near record size, however no marks could be found, and none fit any combination with record calls to bearing trees. A fire has gone through the area, probably shortly after this corner was set and may have killed the bearing trees and they rotted away. However I can not explain why we cannot find the stone. The record distance across this section line is 5,295.84 ft. Our measurement between the two recovered section corners is 5,282.48 ft., a difference of 13.36 ft. With reluctance I determined this corner was lost and re-established by single proportionate measure between found section corners 1/2 mile east and west.



Description of monument and accessories I established to perpetuate the original location of this corner:

Set 2-1/2"x30" aluminum pipe with 3-1/2" aluminum cap, stamped as shown on the DIAGRAM, 26" in the ground.

From which:

Douglas Fir, 14" dia., bears N64°32'W, 16.1 ft., scribed: 1/4 S14 BT
Douglas Fir, 10" dia., bears N58°16'E, 23.9 ft., scribed: 1/4 S14 BT
Ponderosa Pine, 12" dia., bears S55°49'E, 41.7 ft., scribed: 1/4 S23 BT
Douglas Fir, 16" dia., bears S18°22'W, 23.7 ft., scribed: 1/4 S23 BT

Measurements to BT's taken with an Electronic Tacheometer with bearings based on the survey control network. Set steel fence post with Land Survey Monument (54-9) sign 5' south of the monument. Nailed a brass washer stamped PLS 848 on blaze above BT scribe as taken this survey. Nailed Bearing Tree (54-3) signs above blaze and Land Survey Monument (54-9) signs on back of each tree as regulated. Painted a 6" red band above Bearing Trees signs and painted blaze red.

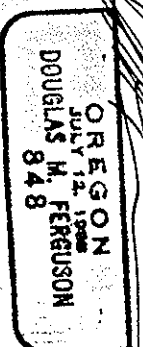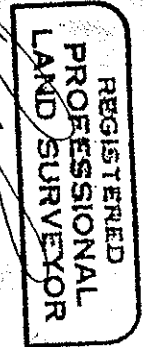

This work was performed by:
Douglas M. Ferguson PLS 848
Witnessed by: D. Mitchell Ferguson
and Rick Sauli
April 23, 1992
Refer to Morrow Co. Survey No.: C-937-E

Office of _____ County of MORROW
state of OR I hereby certify that the within instrument was
filed in this office for record on the 9 day of July, 1992
by _____ (DEPUTY)
(COUNTY OFFICIAL)