

CERTIFIED RECORD OF LAND CORNER MONUMENTATION

INDEX No. N-21

History of original corner establishment:

This corner was originally established by Edward W. Sanderson in 1881-82 under GLO Contract Number 417. Surveyor General Field Notes state:

	T55 R27E
	S14 S13
S23	S24
1992	
PLS 848	

Set sandstone 18x10x5 ins. 12 ins. in ground for Cor. to Secs. 13,14,23,24 marked with 3 notches on S and 1 notch on E. edges. from which

- A Fir 12 in. dia. bears N65°W, 24 lks. dist. marked
- T55 R27E Sec 14 BT
- A Fir 12 in. dia. bears S10°W, 18 lks. dist. marked
- T55 R27E Sec 23 BT
- A Fir 10 in. dia. bears S70°E, 35 lks. dist. marked
- T55 R27E Sec 24 BT
- A Tamarack 12 in. dia. bears N30°E, 23 lks. dist. marked
- T55 R27E Sec 13 BT

Description of Corner Evidence Found:

- Found 16x11x5 stone set in a ring of stone with 3 grooves on face.
- Found rotten fir stump, bears N67°01'W, 14.6 ft. (Rec: N65°W, 15.8 Ft.)
- Western Larch, 18" dia., down with scribing visible, bears N29°39'E, 15.4 ft., (Rec: N30°E, 15.2 ft.)


Description of monument and accessories I established to perpetuate the original location of this corner:

I moved the original corner stone aside and set a 2-1/2"x30" aluminum pipe with 3-1/2" aluminum cap, stamped as shown on the DIAGRAM, 27" in the ground and buried original stone on north side of monument.

From which:

- Douglas Fir, 14" dia., bears N18°45'W, 36.1 ft., scribed: T55 R27E S14 BT
- Douglas Fir, 10" dia., bears N55°00'E, 21.3 ft., scribed: T55 R27E S13 BT
- White Fir, 10" dia., bears S89°30'E, 33.4 ft., scribed: T55 R27E S24 BT
- White Fir, 14" dia., bears S40°15'W, 36.3 ft., scribed: T55 R27E S23 BT

Measurements to BT's taken with a magnetic compass, declination 20° East, and a nylon clad steel tape. Set steel fence post with Land Survey Monument (54-9) sign 4' north of the monument. Nailed a brass washer stamped PLS 848 on blaze above BT scribe as taken this survey. Nailed Bearing Tree (54-3) signs above blaze and Land Survey Monument (54-9) signs on back of each tree as required. Painted a 6" red band above Bearing Tree signs and painted blaze red.

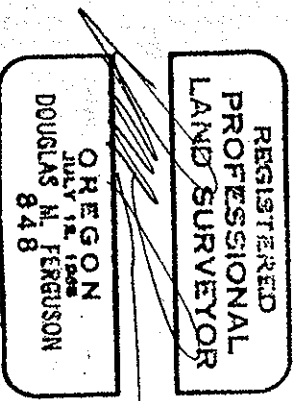

This work was performed by:
 Douglas M. Ferguson PLS 848
 Witnessed by: D. Mitchell Ferguson
 and Rick Saul
 April 23, 1992
 Refer to Morrow Co. Survey No.: C-937-E

Office of DR County of MORROW
 State of OR I hereby certify that the within instrument was
 filed in this office for record on the 9 day of July, 1992
 by SB
 (COUNTY OFFICIAL) (DEPUTY)