

INDEX No. N-3

History of original corner establishment:

DIAGRAM

This corner was originally established by Edward W. Sanderson in 1881-82 under GLO Contract Number 417. Surveyor General Field Notes state:

T5S R27E

S18

1/4 _____

S19

1992

PLS 848

Set sandstone 15x6x6 ins. 10 ins. in ground for 1/4 Sec. Cor. marked 1/4 on W face. from which

A pine 24 ins. dia. bears N30°E, 26 lks dist. marked 1/4 S BT
A pine 22 ins. dia. bears S45°E, 11 lks dist. marked 1/4 S BT

Description of Corner Evidence Found:

Found 15"x6"x6" stone lying loose below fence, clearly marked 1/4. Found original mound of stone from where the stone had rolled out of Monumented center of mound of stone and placed corner stone north of monument.

Found 32" dia. Ponderosa Pine, with scribes 1/4 visible on partially healed upper blaze, bears N34°54'E, 17.3 feet. (Record: N30°E, 17.16 feet) Tree is alive and healthy.

Found 38" dia. Ponderosa Pine, with partial scribes visible on nearly healed up blaze, bears S45°15'E, 5.7 feet. (Record: S45°E, 7.26 ft). Tree is alive and healthy.


Description of monument and accessories I established to perpetuate the original location of this corner:

Set 2-1/2"x30" aluminum pipe with 3-1/2" aluminum cap, stamped as shown on the DIAGRAM, 12" in the ground, in the center of the original mound of stones and buried the original corner stone alongside the north side of the monument. Raised a mound of stone 2' high x 3 3/4' dia around the monument.

From which:

Douglas Fir, 14" dia., bears N81°17'W, 47.9 ft., scribed: 1/4 S18 BT
Ponderosa Pine, 16" dia., bears S12°23'W, 85.7 ft., scribed: 1/4 S19 BT

Measurements to BT's taken with an Electronic Tacheometer with bearings based on the survey control network. Set steel fence post with Land Survey Monument (54-9) and Property Boundary (54-2) signs 5' west and south of the monument. Nailed a brass washer stamped PLS 848 on blaze above BT scribe as taken this survey. Nailed Bearing Tree (54-3) signs above blaze and Land Survey Monument (54-9) signs on back of each tree as required. Painted a 6" red band above Bearing Trees signs and painted blaze red.

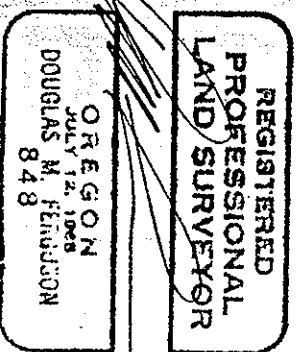

This work was performed by:
Douglas M. Ferguson PLS 848
Witnessed by: D. Mitchell Ferguson
and Rick Sauli
March 26, 1992
Refer to Morrow Co. Survey No.: C-936-E

Office of _____ County of MORROW
State of OR I hereby certify that the within instrument was
filed in this office for record on the 9 day of July, 1992
by SB
(COUNTY OFFICIAL) (DEPUTY)