

CERTIFIED RECORD OF LAND CORNER MONUMENTATION


N-7

History of original corner establishment:

Edward W. Sanderson, under G.L.O. contract number 417, dated Aug. 24, 1881, set a sandstone 15"X 7"X 5" ten inches in the ground. Stone marked $\frac{1}{4}$ " on north face.

From the corner:

A Pine, 15" dia., North, 11 lks.
A Pine, 10" dia., S200E, 20 lks.

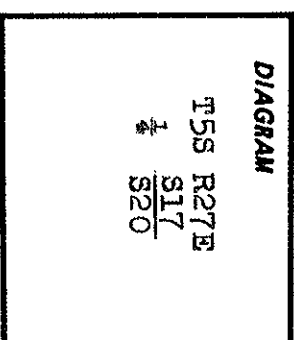

Description of corner evidence found:

From the corner point located at record distance from the original BTs:

A Ponderosa Pine, 16" dia., S7 3/4°E, 13.2 ft. marked: $\frac{1}{8}$ " BT on opened double blazes.
A Ponderosa Pine stub now approx. 12" dia. and 5 ft. high bears N48 $\frac{1}{2}$ °E, 7.3 ft.
This BT has faint scribbling on badly weathered double blazes that face the corner point.

I did not find the original corner stone.

Description of monument and accessories I established to perpetuate the original location of this corner:

At the original corner point I set a 2 $\frac{1}{2}$ "X 30" alum. pipe with a 3" alum. cap containing a magnet and marked:

T55 R27E
 $\frac{1}{4}$ S17
S20
PLS 1832
1986

I built a stone mound around the monument.

From the corner:

A White Fir, 10" dia., N35 $\frac{1}{2}$ °E, 39.8 ft. marked: $\frac{1}{4}$ " S17 BT
A Ponderosa Pine, 25" dia., S50°E, 46.0 ft. marked: $\frac{1}{4}$ " S20 BT

BTs have blaze and a 6" stripe painted red, a BT tag, and an "Attention" sign. New BTs have, additionally, an alum. "PLS 1832" washer nailed to the bottom of the blaze. There is a 6' steel fence post with an "Attention" sign within 5' of the corner.

Measured to center of BTs using steel tape and staff compass. Magnetic declination set at 19°E.

June 30, 1986


State of Oregon I hereby certify that the within instrument was filed in this office


for record on the 31 day of July 1986

by David H. Kumpke by Michelle Daska

(COUNTY OFFICIAL)

RECEIVED BY

(DEPUTY)

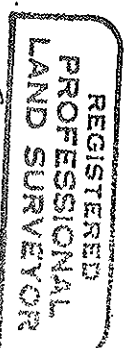

Fayette S. Munro
OREGON
JULY 18, 1979
1832

Form R6-7100-57 (9/71)

Morrow County Surveyor

Date 7/31/86

Rec'd By MLD

No. 830-K