


CERTIFIED RECORD OF LAND CORNER MONUMENTATION

NF-9

History of original corner establishment:

Edward W. Sanderson under G.L.O. contract number 417, dated Aug. 24, 1881, set a sandstone 15"X 12"X 5" ten inches in the ground. Stone marked with 3 notches on the south edge and 4 notches on the east edge.

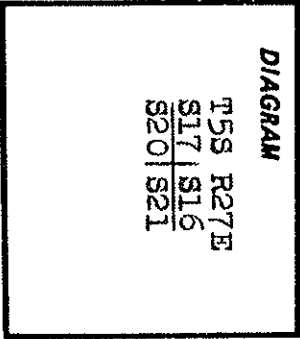

- A Black Pine, 5" dia., N42°0'E, 48 lks.
- A Black Pine, 4" dia., N55°0'W, 10 lks.
- A Black Pine, 4" dia., S35°0'W, 10 lks.
- A Black Pine, 10" dia., S25°0'E, 58 lks.

Description of corner evidence found:

I found a stone 19"X 13"X 6" firmly set 10" in the ground, marked with four grooves on the east face. No grooves visible on the south. I found no evidence of the original BTs.

Description of monument and accessories I established to perpetuate the original location of this corner:

At the original corner point I set a 2 1/2"X 30" alum. pipe with a 3" alum. cap containing a magnet and marked:

T55 R27E
S17 S16
S20 S21
PLS 1832
1986

I buried the original stone alongside and built a stone mound around the monument.

1986

T55 R27E
S17 S16
S20 S21
PLS 1832
1986

1986

- From the corner:
- A Tamarack, 8" dia., N51 1/2°0'E, 25.2 ft. marked: T55 R27E S16 BT
 - A Tamarack, 9" dia., S19°0'E, 48.3 ft.; marked: T55 R27E S21 BT
 - A Tamarack, 14" dia., S41 1/2°0'W, 77.3 ft.; marked: T55 R27E S20 BT
 - A Tamarack, 11" dia., N67°0'W, 43.1 ft.; marked: T55 R27E S17 BT

BTs have blaze and a 6" stripe painted red, a BT tag, an "Attention" sign and an alum. "PLS 1832" washer nailed to the bottom of the blaze. There is a 6' steel fence post with an "Attention" sign within 5' of the corner.

Measured to center of BTs using steel tape and staff compass. Magnetic declination set at 19°E.

June 30, 1986

State of Oregon I hereby certify that the within instrument was filed in this office
for record on the 31 day of July, 1986 by Michelle Datta (DEPUTY)

RECORDED BY

REGISTERED PROFESSIONAL LAND SURVEYOR
Fayette S. Munro
OREGON
JULY 13, 1979
FAYETTE S. MUNRO
1832

Form R6-7100-57 (9/71)


Date 7/31/86

Rec'd By MLD

No. 826-K