

CERTIFIED RECORD OF LAND CORNER MONUMENTATION

R27E

INDEX No. P-1

History of original corner establishment:

DIAGRAM

This corner was originally established by  
Edward A. Thatcher in 1879 under GLO  
Contract Number 325. Surveyor General Field  
Notes state:

T5S R27E  
1/4  
R26E | R27E  
S24 | S19  
PLS 1832  
1986

Set a stone 13x13x5 ins. and raised a mound  
of stone at the corner.

In 1986, Fayette S. Munro, PLS 1821, remonumented this corner from  
found original evidence. His record states:

I found a stone 12"x12"x7" marked: 1/4; in a small stone mound.

At the original corner point I set a 2" x 30" alum. pipe with a 3"  
alum. cap containing a magnet and marked: (SEE DIAGRAM)

I buried the original stone alongside and built a stone mound around  
the monument.

From the corner:

A Ponderosa Pine, 12" dia., N23°E, 70.2 ft. marked: 1/4 S19 BT  
A Ponderosa Pine, 11" dia., N44 3/4°W, 23.6 ft., marked: 1/4 S24 BT

BTS have blaze and a 6" stripe painted red, a BT tag, an "Attention"  
sign and an alum. "PLS 1832" washer nailed to the bottom of the blaze.  
There is a 6' steel fence post with an "Attention" sign within 5' of  
the corner. Measured to center of BTS using steel tape and staff  
compass. Magnetic declination set at 19°E. June 29, 1986.

Description of Corner Evidence Found:

Found 2" pipe with 3" cap stamped as shown in Diagram. Monument is  
surrounded by a mound of stone and in good condition.

Ponderosa Pine, 12" dia., with healed blaze, bears N45°45'W, 23.52 ft.  
(Rec: Munro N44 3/4°W, 23.6 ft.)

Ponderosa Pine, 12" dia., with healed blaze, bears N22°05'E, 70.02 ft.  
(Rec: Munro N23°E, 70.20 ft.)



Description of monument and accessories I established to perpetuate the  
original location of this corner:

No work is needed on the monument.

From which:

Douglas Fir, 12" dia., bears S44°30'E, 7.6 ft., scribed: 1/4 S19 BT  
White Fir, 16" dia., bears S12°15'W, 43.8 ft., scribed: 1/4 S24 BT

Measurements to BT's taken with a magnetic compass, declination 20° East,  
and a nylon clad steel tape. Set steel fence post with Land Survey  
Monument (54-9) and Property Boundary (54-2) signs 5' north of the  
monument. Nailed a brass washer stamped PLS 848 on blaze above BT scribe  
as taken this survey. Nailed Bearing Tree (54-3) signs above blaze and  
Land Survey Monument (54-9) signs on back of each tree as required.  
Painted a 6" red band above Bearing Trees signs and painted blaze red.

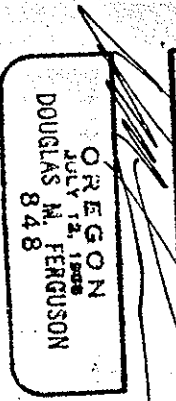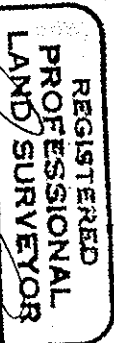

This work was performed by:  
Douglas M. Ferguson PLS 848  
Witnessed by: D. Mitchell Ferguson  
and Rick Saul  
March 23, 1992  
Refer to Morrow Co. Survey No.: C-936-E

Office of \_\_\_\_\_ County of MORROW  
State of OR I hereby certify that the within instrument was  
filed in this office for record on the 9 day of July, 1992  
by SB

(COUNTY OFFICIAL) (DEPUTY)