

CERTIFIED RECORD OF LAND CORNER MONUMENTATION

INDEX No. P-3

History of original corner establishment:

None. Corner established this survey.

DIAGRAM

T55 R27E
C 1/4

S19
1992
PLS 848

Description of Corner Evidence Found:


None. Corner established this survey.

Description of monument and accessories I established to perpetuate the original location of this corner:

Set 2-1/2"x30" aluminum pipe with 3-1/2" aluminum cap, stamped as shown on the DIAGRAM, 24" in the ground.
From which:

Western Larch,	12" dia.,	bears N59°45'W,	39.9 Ft.,	scribed: C1/4	S19	BT
Lodgepole Pine,	16" dia.,	bears N15°08'W,	70.8 ft.,	scribed: C1/4	S19	BT
Douglas Fir,	12" dia.,	bears N65°47'E,	22.3 ft.,	scribed: C1/4	S19	BT
Douglas Fir,	22" dia.,	bears S09°48'E,	5.1 ft.,	scribed: C1/4	S19	BT

Measurements to BT's taken with an Electronic Tacheometer with bearings based on the survey control network. Set steel fence post with Land Survey Monument (54-9) sign 4' north of the monument. Nailed a brass washer stamped PLS 848 on blaze above BT scribe as taken this survey. Nailed Bearing Tree (54-3) signs above blaze and Land Survey Monument (54-9) signs on back of each tree as required. Painted a 6" red band above Bearing Trees signs and painted blaze red.

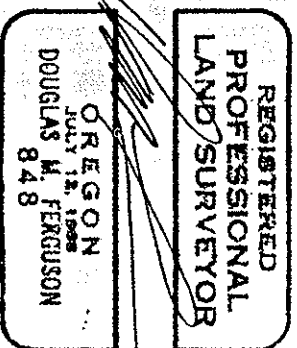

This work was performed by:
Douglas M. Ferguson PLS 848
Witnessed by: D. Mitchell Ferguson
and Rick Sauli
April 8, 1992
Refer to Morrow Co. Survey No.: C-936-E

Office of _____ County of MORROW
State of OR I hereby certify that the within instrument was
filed in this office for record on the 9 day of July, 1992
by SR
(COUNTY OFFICIAL) (DEPUTY)