

CERTIFIED RECORD OF LAND CORNER MONUMENTATION

INDEX No. P-5

History of original corner establishment:

DIAGRAM

This corner was originally established by Edward W. Sanderson in 1881-82 under GLO Contract Number 417. Surveyor General Field Notes state:

T5S R27E

1/4

S19•S20

Marked a fir 6 in. dia. for 1/4 sec. cor. marked 1/4 S on W. face from which

1992

PLS 848

A fir 24 ins. dia. bears East, 35 lks dist. marked 1/4 S BT
A fir 6 ins. dia. bears N70°W, 11 lks dist. marked 1/4 S BT

Description of Corner Evidence Found:

Three different search areas were determined due to the fact the overall distance on the section line was long by 87 feet. An extensive search was conducted in all three areas and those in between however no evidence was recovered.

The search areas are a mass of down rotten wood. There is a location poster in the area, approximately 15 feet east of the proportion position, dated 11/12/56, RLG & TJD. However, no evidence was found near or around this location poster. I declared this corner lost and re-established it's position by single proportion measurement based on the remonumented section corners (from original evidence) 1/2 mile north and south.


Description of monument and accessories I established to perpetuate the original location of this corner:

Set 2-1/2"x30" aluminum pipe with 3-1/2" aluminum cap, stamped as shown on the DIAGRAM, 26" in the ground.

From which:

Ponderosa Pine, 30" dia., bears N57°53'W, 41.4 ft., scribed: 1/4 S19 BT
White Fir, 16" dia., bears N25°24'E, 33.3 ft., scribed: 1/4 S20 BT
Douglas Fir, 14" dia., bears S45°17'E, 8.9 ft., scribed: 1/4 S20 BT
White Fir, 14" dia., bears S41°42'W, 78.1 ft., scribed: 1/4 S19 BT

Measurements to BT's taken with an Electronic Tacheometer with bearings based on the survey control network. Set steel fence post with Land Survey Monument (54-9) and Property Boundary (54-2) signs 5' north and east of the monument. Nailed a brass washer stamped PLS 848 on blaze above BT scribe as taken this survey. Nailed Bearing Tree (54-3) signs above blaze and Land Survey Monument (54-9) signs on back of each tree as required. Painted a 6" red band above Bearing Trees signs and painted blaze red.

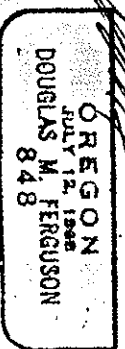

This work was performed by:
Douglas M. Ferguson PLS 848
Witnessed by: D. Mitchell Ferguson
and Rick Saul
APRIL 8, 1992
Refer to Morrow Co. Survey No.: C-936-E

Office of OR County of MORROW
State of OR I hereby certify that the within instrument was
filed in this office for record on the 9 day of July, 1992

(COUNTY OFFICIAL)

by SB

(DEPUTY)