

CERTIFIED RECORD OF LAND CORNER MONUMENTATION

INDEX No. R-5

History of original corner establishment:

DIAGRAM

This corner was originally established by Edward W. Sanderson in 1881-82 under GLO Contract Number 417. Surveyor General Field Notes state:

T55 R27E W C	
S19 S20	
S30 S29	
1992	
PLS 848	

Marked a fir 8 in. dia. for Cor. to Secs. 19, 20, 29 and 30. Marked
 T55 Sec. 20 on NE
 R27E Sec. 29 on SE
 Sec 30 on SW
 Sec 19 on NW
 from which

A Tamarack 6 in. dia. bears N50°E, 16 lks. dist marked
 T55 R27E Sec. 20 BT
 A black pine 6 in. dia. bears S40°E, 12 lks. dist. marked
 T55 R27E Sec. 29 BT
 A Tamarack 8 in. dia. bears N60°W, 16 lks. dist. marked
 T55 R27E Sec. 19 BT
 A Tamarack 6 in. dia. bears S35°W, 31 lks. dist. marked
 T55 R27E Sec. 30 BT

Description of Corner Evidence Found:

Corner tree, 15" white Fir with healed blazes in each quadrant.
 Tamarack, down with some scribing visible, bears N53°39'W, 11.18 ft., to root hole. (Rec: N60°W, 16 lks.)


Description of monument and accessories I established to perpetuate the original location of this corner:

Since the corner tree cannot be occupied, I set 2-1/2"x30" aluminum pipe with 3-1/2" aluminum cap, stamped as shown on the DIAGRAM, 27" in the ground, for a witness corner, 10 ft. north, on line, for the corner tree.

From the Corner Tree:

Lodgepole pine, 10" dia., bears N17°12'W, 118.9 ft., scribed: T55 R27E S19 BT
 White Fir, 20" dia., bears N67°36'E, 42.1 ft., scribed: T55 R27E S20 BT
 White Fir, 26" dia., bears S60°24'E, 41.7 ft., scribed: T55 R27E S29 BT
 Douglas Fir, 28" dia., bears S00°21'W, 40.4 ft., scribed: T55 R27E S30 BT

Measurements to BT's taken with an Electronic Tacheometer with bearings based on the survey control network. Set steel fence post with Land Survey Monument (54-9) sign 5' north of the corner tree. Nailed a brass washer stamped PLS 848 on blaze above BT scribe as taken this survey. Nailed Bearing Tree (54-3) signs above blaze and Land Survey Monument (54-9) signs on back of each tree as required. Painted a 6" red band above Bearing Trees signs and painted blaze red. Painted and signed corner tree.

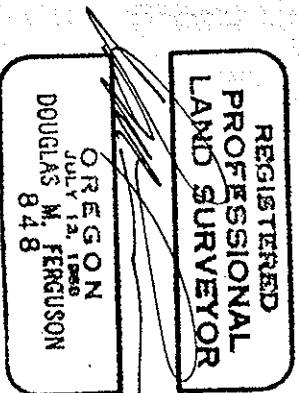

This work was performed by:
 Douglas M. Ferguson PLS 848
 Witnessed by: D. Mitchell Ferguson
 and Rick Saul
 April 25, 1992
 Refer to Morrow Co. Survey No.: C-936-E

Office of OR I hereby certify that the within instrument was
 State of OR filed in this office for record on the 9 day of July, 1992
 County of MORROW
 by SB
 (COUNTY OFFICIAL) (DEPUTY)