

CERTIFIED RECORD OF LAND CORNER MONUMENTATION

INDEX No. R-9

History of original corner establishment:

DIAGRAM

This corner was originally established by Edward W. Sanderson in 1881-82 under GLO Contract Number 417. Surveyor General Field Notes state:

T55	R27E
S20	S21

Set sandstone 18x7x4 ins. 12 ins. in ground for Cor. to Secs. 20, 21, 28 and 29 marked with 2 notches on S. and 4 notches on E. edges from which

S29	S28
1992	
PLS 848	

A Fir 6 ins. dia. bears S80°W, 28 lks. dist. marked T55 R27E Sec. 29 BT
 A Fir 8 ins. dia. bears N50°W, 57 lks. dist. marked T55 R27E Sec. 20 BT
 A Fir 6 ins. dia. bears N40°E, 18 lks. dist. marked T55 R27E Sec. 21 BT
 A Fir 9 ins. dia. bears S45°E, 13 lks. dist. marked T55 R27E Sec. 28 BT

Description of Corner Evidence Found:

Found original stone, marked with 4 grooves on east face and 2 grooves on south face, firmly set in the ground.

White Fir, 22" dia., with double healed blazes, bears N23°51'E, 10.9 ft. (Rec: N40°E, 11.88 ft.)

White Fir, 20" dia., with double healed blazes, bears S49°14'E, 7.6 ft. (Rec: S45°E, 8.58 ft.)


Description of monument and accessories I established to perpetuate the original location of this corner:

Moving the original corner stone aside, I set 2-1/2"x30" aluminum pipe with 3-1/2" aluminum cap, stamped as shown on the DIAGRAM, 27" in the ground and buried the original stone on the north side of the monument.

From which:

Douglas Fir, 22" dia., bears S77°06'W, 27.3 ft., scribed: T55 R27E S29 BT
 White Fir, 20" dia., bears N01°24'W, 27.3 ft., scribed: T55 R27E S20 BT

Measurements to BT's taken with an Electronic Tacheometer with bearings based on the survey control network. Set steel fence post with Land Survey Monument (54-9) sign 5' north of the monument. Nailed a brass washer stamped PLS 848 on blaze above BT scribe as taken this survey. Nailed Bearing Tree (54-3) signs above blaze and Land Survey Monument (54-9) signs on back of each tree as required. Painted a 6" red band above Bearing Trees signs and painted blaze red.

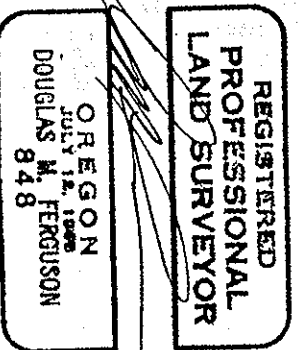

This work was performed by:
 Douglas M. Ferguson PLS 848
 Witnessed by: D. Mitchell Ferguson
 and Rick Saul
 April 24, 1992
 Refer to Morrow Co. Survey No.: C-936-E

Office of _____ County of MORROW
 State of OR I hereby certify that the within instrument was
 filed in this office for record on the 9 day of July, 1992
 by SR
 (COUNTY OFFICIAL) (DEPUTY)