

CERTIFIED RECORD OF LAND CORNER MONUMENTATION

Refer to: Plat of Stahl 1990 Cadastrol Survey
Sections 4 and 8, T.6S., R.27E., W.M.

Z-3

DIAGRAM

S C
T58 R27E
1/4 S31

History of original corner establishment:
George S. Pershin, surveying the First Standard
Parallel South under G.L.O. contract no. 362, dated
Aug. 2, 1880, marked a 4" dia. Hemlock for this
corner from which:

A Tamarack, 10" dia., N32°W, 11 lks.
A Hemlock, 8" dia., N28°E, 8 lks.

Edward W. Sanderson, retracing under G.L.O. contract
no. 368, dated Sep 7, 1880, found the corner tree,
a fir, 9" dia. from which:

A Tamarack, 10" dia., N45°W, 12 lks.
A fir, 9" dia., N20°E, 9 lks.

Description of corner evidence found:

From the corner point established from evidence of the original BTs per
Pershin's record which best fits the evidence:

A badly decayed stump, approx. 16" dia.; with reverse scribbling "BT"
visible on shell of stump; bears N32°W, 7.3 ft.
A root hole, N28°E, 5.3 ft.

**Description of monument and accessories established to perpetuate the
original location of this corner:**

At the corner point I set a 2 1/2" x 30" alum. pipe
with a 2 1/2" alum. cap mkd.;
Monument is 24" in the ground.
From the corner:

S C
T58 R27E
1/4 S31
PLS 1832
1990

5/8" x 30" rebar driven 26" in ground, N42 1/4°E, 12.8 ft.;


with yellow plastic "PLS 1832" cap.
6' steel fence post driven in ground with "Land Survey Monument" sign
attached; bears west, 3.3 ft.

A white fir, 16" dia., N71 3/4°E, 39.0 ft.; mkd.; 1/4 S31 SC BT
A western larch, 16" dia., N46 1/2°W, 59.7 ft.; mkd.; 1/4 S31 SC BT

BTs have blaze and a 6" band painted red, BT tags and "Land Survey
Monument" signs. New BTs have, additionally, alum. "PLS 1832" washers
nailed to the bottom of the blaze.

Measured to center of BTs using steel tape and staff compass. Magnetic
declination set at 19°E.

Sep. 13, 1990

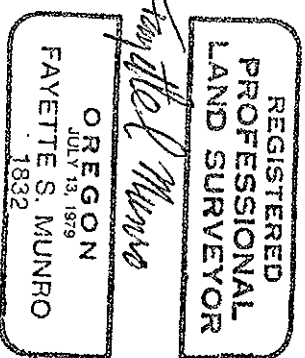

Office of..... County of.....
State of....., I hereby certify that the within instrument was filed in this office
for record on the..... day of....., 19.....
..... by (DEPUTY)
..... (COUNTY OFFICIAL)

Form RS-7100-57 (9/71)

RECEIVED BY

Morrow County Surveyor

Date 1/91

Rec'd By [Signature]

No. C-904 Z-3