

CERTIFIED RECORD OF LAND CORNER MONUMENTATION

Refer to: Plat of Stahl 1990 Cadastral Survey
Sections 4 and 8, T.6S., R.27E., W.M.

Z-5

DIAGRAM

S C
T55 R27E
S31 | S32

History of original corner establishment:

George S. Pershin, surveying the First Standard Parallel South under G.L.O. contract no. 362, dated Aug. 2, 1880, set a pine post from which:
A Fir, 10" dia., N60W, 48 lks.
A Fir, 10" dia., N420E, 17 lks.
Edward W. Sanderson, subdividing T.5S., R.27E. under G.L.O. contract no. 368, dated Sep. 7, 1880, found a post, 4" dia., firmly set, from which:
A Fir, 10" dia., N400E, 18 lks.
A Fir, 9" dia., N50W, 49 lks.

Description of corner evidence found:


I found one remaining original BT; from the corner point established per Sanderson's record;
A Douglas Fir, 23" dia., N50W, 32.3 ft.; with scribing visible..

Description of monument and accessories I established to perpetuate the original location of this corner:

I set a 2 1/2" x 30" alum. pipe with a 2 1/2" alum. cap mkd.:
Monument is 24" in ground.
From the corner:
S C
T55 R27E
S31 | S32
PLS 1832
1990

6' steel fence post driven in ground with "Land Survey Monument" sign attached, bears N610E, 4.0 ft.
A White Fir, 19" dia., N30 1/2 0W, 47.4 ft.; mkd.: T55 R27E S31 SC BT
A Douglas Fir, 19" dia., N170E, 10.8 ft.; mkd.: T55 R27E S32 SC BT
A Lodgepole Pine, 11" dia., N63 3/4 0W, 44.3 ft.; mkd.: T55 R27E S31 SC BT
BTS have blaze and a 6" band painted red, BT tags and "Land Survey Monument" signs. New BTS have, additionally, alum. "PLS 1832" washers nailed to the bottom of the blaze.
Measured to center of BTS using steel tape and staff compass. Magnetic declination set at 18 3/4 0E.

Sep. 13, 1990

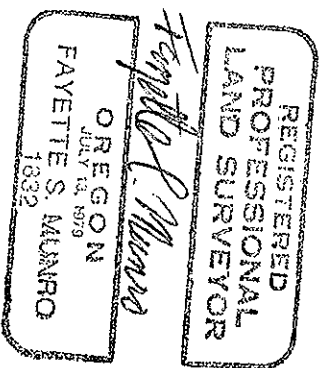

Office of..... County of.....
State of..... I hereby certify that the within instrument was filed in this office
for record on the..... day of....., 19.....
..... by (DEPUTY)
(COUNTY OFFICIAL)

Form R6-7100-57 (9/71)

RECEIVED BY
Morrow County Surveyor

Date 11/91
Page 88
No. C-904 Z-5