


CERTIFIED RECORD OF LAND CORNER MONUMENTATION

A-11

History of original corner establishment:

Work for Section 4 was done by Edward W. Trudeau on August 24, 1881, under Contract No. 417.

From B.L.M. notes, there is no record of the corner being reset when correction was made on the line of the Township.

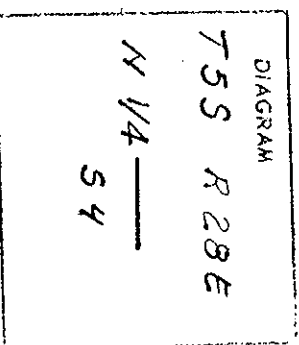

No record of subsequent remonumentation found in County Records.

Description of corner evidence found:

No evidence found.

I set the monument described below at the midpoint between the found NW corner and the NE corner of Section 4.

Description of monument and accessories I established to perpetuate the original location of this corner

At the position described above, I set a 2 1/2" x 30" iron pipe 20" in the ground, with a brass cap marked as shown:

From which I scribed BTs:

A fir 1 1/2" in diam. bears S 60° E 23.9' marked 1/4 S 4 T 5S R 28E BT.
A fir 9" in diam. bears S 11° E 19.3' marked 1/4 S 4 T 5S R 28E BT.

I nailed a brass washer marked PLS 1638 to the BT blazes.

I set a steel fence post 5' East.


I painted a red band around the BTs and face of scribe.

I used a steel tape and a magnetic compass with 21° East variation and measured a horizontal distance to the center of BTs.

This corner was set November 5, 1979.

Witness by W. Keith Sands, Roderick D. Punches, and Dennis L. Paasch.

K. CISTLER, D
PROFESSIONAL
LAND SURVEYOR
TERRY E. HAMBLY
1638
JULY 14, 1978
OREGON

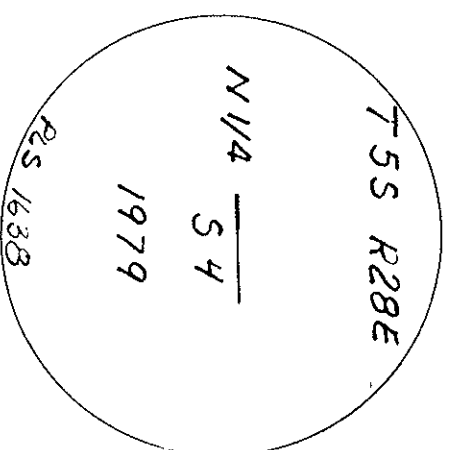

Office of County Surveyor Morrow
State of Oregon, I hereby certify that the within instrument was filed in this office
for record on the 5th day of Dec. 1979 by
David H. Klein (COUNTY OFFICIAL) (DEPUTY)

RECEIVED BY
Morrow County Surveyor
Date 12-10-79
Rec'd By TMDJ
No. 262-K

Corresponding drawing