


CERTIFIED RECORD OF LAND CORNER MONUMENTATION

B-13

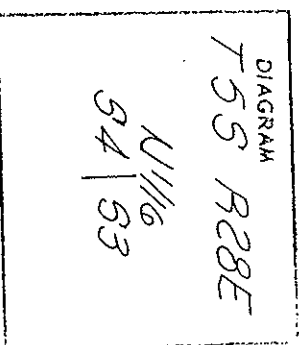

History of original corner establishment:

Unsurveyed - subdivided Section.

No record of subsequent remonumentation found in County Records.

Description of corner evidence found:

No evidence found.

I set the monument described below by protraction from the found W 1/2 and NW corner of Section 3.

Description of monument and accessories I established to perpetuate the original location of this corner

At the position described above, I set a 2 1/2" x 30" iron pipe 25" in the ground, with a brass cap marked as shown:

From which I scribed BTs:

A lodge pine 15" in diam. bears N 70° W 10.3' marked N 1/16 S 4 T 5 S R 28E BT.  
A lodge pine 15" in diam. bears N 88° E 36.6' marked N 1/16 S 3 T 5S R 28E BT.

I nailed a brass washer marked PLS 1638 to the BT blazes.

I set a steel fence post 5' South and 5' East.

I painted a red band around the BTs and face of scribe.


I used a steel tape and a magnetic compass with 21° East variation and measured a horizontal distance to the center of BTs.

This corner was set October 30, 1979.

Witness by W. Keith Sands.

REGISTERED  
PROFESSIONAL  
LAND SURVEYOR

*Terry E. Hamby*  
OREGON  
JULY 14, 1978  
TERRY E. HAMBY  
1638

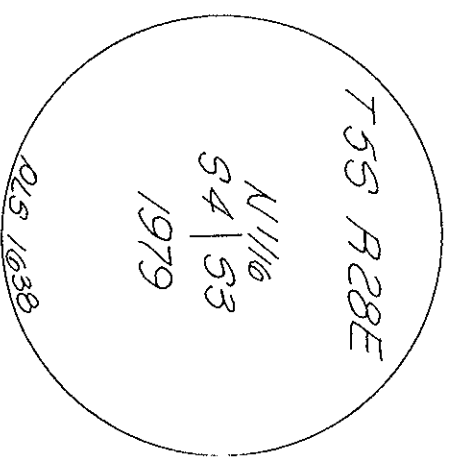

Office of ..... County Surveyor ..... Morrow  
State of Oregon, I hereby certify that the within instrument was filed in this office  
for record on the 1<sup>st</sup> day of Dec. 1979.  
*Donald H. Klevin* by .....  
(COUNTY OFFICIAL) (DEPUTY)

RECEIVED BY  
Morrow County Surveyor  
Date 12-10-79  
Rec'd By MMVJ  
No. 266-K

