


CERTIFIED RECORD OF LAND CORNER MONUMENTATION

B-15

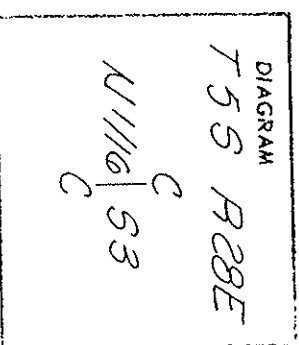

History of original corner establishment:

Unsurveyed - subdivided Section.

No record of subsequent remonumentation found in County Records.

Description of corner evidence found:

No evidence found.

I set the monument described below by protraction from the computed C 1/4 and the N 1/4 of Section 3.

R. GIST, R.L.D.
PROFESSIONAL
LAND SURVEYOR

Terry E. Hamby
OREGON
JULY 14, 1988
TERRY E. HAMBY
1638

Description of monument and accessories | established to perpetuate the original location of this corner

At the position described above, I set a 2 1/2" x 30" iron pipe 24" in the ground, with a brass cap marked as shown:

From which I scribed BTs:

A fir 1 1/2" in diam. bears N 18° W 26.9' marked CN 1/16 S 3 BT with signs.
A pine 10" in diam. bears S 14° W 23.0' marked CN 1/16 S 3 BT with signs.

I nailed a brass washer marked PLS 1638 to the BT blazes.


I set a steel fence post 5' West and 5' South.

I painted a red band around the BTs and face of scribe.

I used a steel tape and a magnetic compass with 21° East variation and measured a horizontal distance to the center of BTs.

This corner was set October 30, 1979.

Witness by W. Keith Sands.

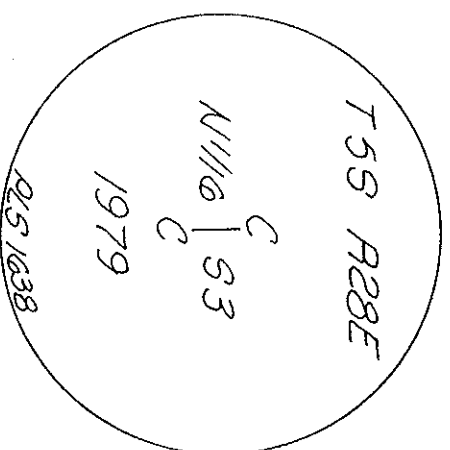

Office of County Surveyor County of Morrow
State of Oregon, I hereby certify that the within instrument was filed in this office
for recording on the 1st day of Dec. 1979 by
(COUNTY OFFICIAL) (DEPUTY)

RECEIVED BY

Morrow County Surveyor
Date 12-10-79
Rec'd By MAJI
No. 266-K

Consolidating drawing

#266-K