


CERTIFIED RECORD OF LAND CORNER MONUMENTATION

C-11

History of original corner establishment:

Unsurveyed - subdivided Section.

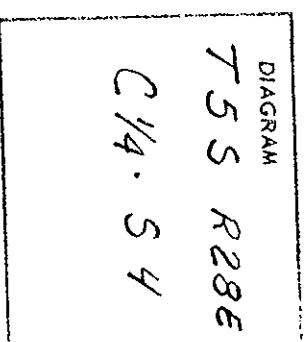

No record of subsequent remonumentation found in County Records.

Description of corner evidence found:

No evidence found.

I set the monument described below at the point of intersection of the found four  $\frac{1}{4}$ 's of Section 4.

Description of monument and accessories established to perpetuate the original location of this corner

At the position described above, I set a  $2\frac{1}{2}$ " x 30" iron pipe 24" in the ground, with a brass cap marked as shown:

From which I scribed BTs:

A lodge pine 8" in diam. bears N  $34^{\circ}$  W 15.0' marked C  $\frac{1}{4}$  S 4 BT.  
A lodge pine 12" in diam. bears S  $73^{\circ}$  S 26.7' marked C  $\frac{1}{4}$  S 4 BT.

I nailed a brass washer marked PLS 1638 to the BT blazes.

I set a steel fence post 5' North.

I painted a red band around the BTs and face of scribe.

I used a steel tape and a magnetic compass with  $21^{\circ}$  East variation and measured a horizontal distance to the center of BTs.

This corner was set November 5, 1979.

Witness by Dennis L. Paasch and W. Keith Sands.

REGISTERED  
PROFESSIONAL  
LAND SURVEYOR

*Terry E. Hamby*

OREGON  
JULY 14, 1978  
TERRY E. HAMBY  
1638

T5S R28E  
C1/4 S4  
1979  
PLS 1638

Office of County Surveyor Morrow County of Morrow

State of Oregon, I hereby certify that the within instrument was filed in this office

for record on the 4 day of Dec, 1979  
*Dennis L. Paasch*  
(COUNTY OFFICIAL)

by W. Keith Sands (DEPUTY)

RECEIVED BY

Morrow County Surveyor

Date 12-10-79

Rec'd By WKS

No. 262-K

CONTEMPORARY  
DRAWING