


CERTIFIED RECORD OF LAND CORNER MONUMENTATION

C-15

History of original corner establishment:

Unsurveyed - subdivided Section.

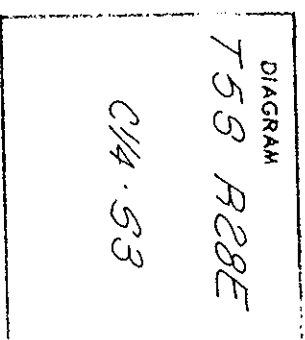

No record of subsequent remonumentation found in County Records.

Description of corner evidence found:

No evidence found.

I set the monument described below at the point of intersection of the four 1/4's of Section 3.

Description of monument and accessories I established to perpetuate the original location of this corner

At the position described above, I set a 2 1/2" x 30" iron pipe 23" in the ground, with a brass cap marked as shown:

From which I scribed BTs:

REGISTERED
PROFESSIONAL
LAND SURVEYOR

Terry E. Hamby

OREGON
JULY 14, 1978
TERRY E. HAMBY
1638

A lodge pine 13" in diam. bears N 74° E 10.9' marked C 1/4 S 3 T 5S R 28E BT with signs.
A lodge pine 14" in diam. bears S 71° W 12.8' marked C 1/4 S 3 T 5S R 28E BT with signs.

- I nailed a brass washer marked PLS 1638 to the BT blazes.
- I set a steel fence post 5' North and 5' South with signs.
- I painted a red band around the BTs and face of scribe.
- I used a steel tape and a magnetic compass with 21° East variation and measured a horizontal distance to the center of BTs.

This corner was set November 1, 1979.

Witness by W. Keith Sands and Jerry I. Ogawa.

T58 R28E
C14.53
1979
PLS 1638

Office of _____ County Surveyor _____ County of _____ MORROW _____
State of Oregon _____, I hereby certify that the within instrument was filed in this office
for record on the 1st day of Dec. 1979.
David H. Klein by _____ (DEPUTY)
(COUNTY OFFICIAL)

RECEIVED BY

Morrow County Surveyor
Date 12-10-79
Rec'd By MAI
No. 266-K

Consolidating drawing