

CERTIFIED RECORD OF LAND CORNER MONUMENTATION

INDEX NO. C-5

History of original corner establishment:

Corner originally established in 1881, by Edward W. Sanderson, under General Land Office Contract No. 417, Surveyor Generals Notes State: (See official GLO Notes)

DIAGRAM
(not on cap)
(T55 R28E)
1/4
S6155
1938
GLO

In 1938 Leonard Carter, Cadastral Engineer for the "General Land Office" performed a Dependent Resurvey, Those Notes State: Proportional measure set an iron post, 3 ft. long, 12ins. diam., 28 ins. in the ground, for the 1/4 sec. cor., with brass cap stamped: (As shown on the DIAGRAM) From which:

A Douglas fir, 30 ins. diam., bears S40°E., 161 lks. mkd. 1/4 S5 BT
A Douglas fir, 22 ins. diam., bears N29-1/2°W., 26 lks. mkd. 1/4 S6 BT

Description of corner evidence found:

Found 1" iron pipe with 2-1/2P brass cap, stamped as shown on the DIAGRAM, set with cap 8" above ground.

From which:

Found a Fir 36" dia., live in good condition, with blaze healed over, Bears, S40°E., 17.0 ft.

(Record S40°E., 106.3 ft.) This is an original bearing tree as taken in 1938, the notes are apparently in error.

Description of monument and accessories | established to perpetuate the original location of this corner:

Maintained Corner by setting a steel post with warning sign, North 1 ft. from the GLO monument.

Maintained Accessories by taking a new Bearing Tree.

A Fir 24" dia. Bears, S62°W., 25.3 ft. scribed: 1/4 S6 BT.

Measurements to trees taken with a metal tape and magnetic compass, with Declination set off 20 deg. East.

Nailed a brass washer stamped PLS 848 on blaze above BT scribe, Bearing Tree Sign above blaze, and warning sign on back of each tree. Painted a 6" red band at breast ht. around each tree.


RECORDED BY

Morrow County Surveyor

Date 1-10-86

Lead-7 DMLD

No. 738-K

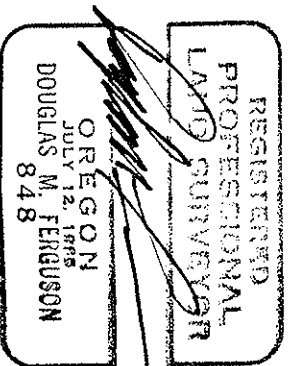

Work by D.M. Ferguson, PLS 848, Mt. Vernon Ore.
On Aug. 8, 1984

Witnessed by J. David Brinton, PLS 2065

Office of SURVEYOR County of WASCO
State of Oregon I hereby certify that the within instrument was filed in this office
for record on the 10 day of September 1985
by David H. Krumbein David H. Krumbein Raywell
(COUNTY OFFICIAL) (DEPUTY)