


RECORD OF LAND CORNER MONUMENTATION

CENTER-WEST 1/16 CORNER SECTION 5, T. 5 S., R. 28 E., W.M.

ORIGINALLY ESTABLISHED BY: Douglas M. Ferguson, PLS 848

COUNTY SURVEYOR DOCUMENTATION: Map of Survey recorded 1/10/86 as D-801-K-650 and associated monumentation record filed 1/10/86

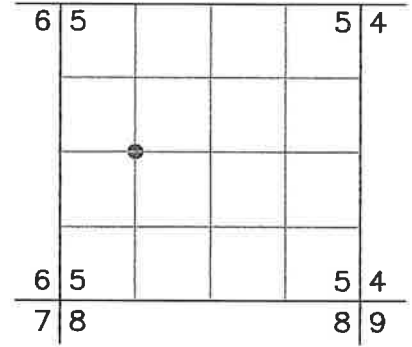

ORIGINAL DESCRIPTION: Set a 2-1/2"x30" aluminum pipe with 2-1/2" aluminum cap, stamped as shown on the DIAGRAM, set 24" in the ground.
From which,

- A Fir, 10" dia. Bears, S60°W., 26.6 ft., scribed: C-W 1/16 S5 BT
- A Fir, 6" dia. Bears, N53°E., 2.3 ft., scribed: C-W 1/16 S5 BT

EVIDENCE FOUND: Found a 2 1/2" aluminum pipe with a 2 1/2" aluminum cap projecting 7" above ground. From which, the following bearing trees were found:

- ▶ A fir, dead and down, bears N.53°E., 2.3 ft.
- ▶ A fir, dead and down, bears S.60°W., 26.6 ft.


DESCRIPTION OF MONUMENTS AND ACCESSORIES SET AND METHODS USED:
I accept the found aluminum monument for the true corner position.

MONUMENT MARKED:

From which, I SCRIBE THE FOLLOWING NEW BEARING TREES:

- ▶ A western larch, 8" dbh bears N.59°E., 14.25 ft. marked "CW1/16 S5 BT"
- ▶ A ponderosa pine, 9" dbh bears S.39°E., 17.30 ft. marked "CW1/16 S5 BT"

Painted a 6 inch red band around the bearing trees, and also painted the blazes red. Attached USFS signs 54-3 and 54-9 to the bearing trees. Distances to bearing trees were measured with a steel tape to a 60d nail driven in the side-center-right at the root crown of each tree. Bearings were measured with a magnetic compass with 14° East declination.

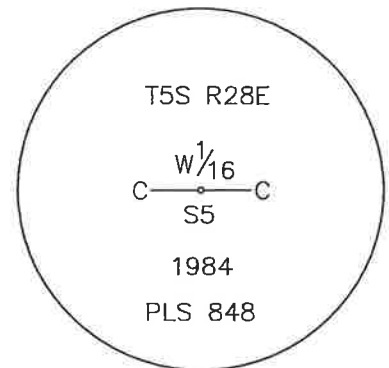

RESTORATION BY, STAMP AND DATE:

Work Performed September 29, 2021 by:

Vincent Kelly, Survey Technician
Daniel B. Lee

USDA FOREST SERVICE
NORTHEAST OREGON LAND ZONE
1550 Dewey Avenue, Suite A
Baker City, OR 97814
(541) 523-1337

RECEIVED BY
Morrow County Surveyor
Date: 1-5-2022
Rec'd By: MPK
No.: SS2806
~~Folder No.:~~ _____

REGISTERED
PROFESSIONAL
LAND SURVEYOR

Jason L. Hatfield
OREGON
NOVEMBER 30, 2007
JASON L. HATFIELD
#69454

EXPIRES: 6/30/2023