

CERTIFIED RECORD OF LAND CORNER MONUMENTATION

INDEX NO. C-6

History of original corner establishment:

Corner not previously established.

DIAGRAM	
TSS	R22E
W1/16	
C-,-C	
95	
1984	
PLS	848

Description of corner evidence found:

Corner not previously established.

Description of monument and accessories | established to perpetuate the original location of this corner:

Set 2-1/2" x 30" aluminum pipe with 2-1/2" aluminum cap, stamped as shown on the DIAGRAM, SET 24" in the ground.

From which,

A Fir 10" dia. Bears, S60°W., 26.6 ft., scribed: C-W 1/16 SS BT

A Fir 6" dia. Bears, N53°E., 2.3 ft., scribed: C-W 1/16 SS BT

Measurements to trees taken with a metal tape and magnetic compass,


with Declination set off 20 deg. East.

Nailed a brass washer stamped PLS 848 on blaze above BT scribe, Bearing

Tree sign above blaze, and warning sign on back of each tree. Painted

a 6" red band at breast ht. around each tree. Set steel fence posts with

warning & Boundary Signs, North 5 ft. & South approx. 40 ft. from the corner.

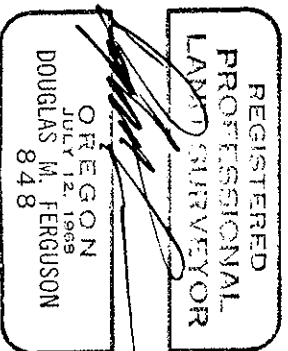

RECEIVED BY
Morrow County Surveyor
Date 1-10-86
Rec'd by MLD
No. 728-K

Work by D.M. Ferguson, PLS 848, Mt. Vernon Ore.
On Aug. 7, 1984

Witnessed by J. David Brinton, PLS 2065

Office of Swain Taylor County of MORROW
 State of OREGON I hereby certify that the within instrument was filed in this office
 for record on the 10th day of September, 1985
David H. Krause by B. Mark Reynolds
 (COUNTY OFFICIAL) (DEPUTY)