

CERTIFIED RECORD OF LAND CORNER MONUMENTATION

INDEX No. C-7

History of original corner establishment:

Corner not previously established.

<b>DIAGRAM</b>
T59 R28E
C1/4
S5
1984
PLS 84B

Description of corner evidence found:

Corner not previously established.

Description of monument and accessories | established to perpetuate the original location of this corner:

Set 2-1/2"x30" aluminum pipe with 2-1/2" aluminum cap, stamped as shown on the **DIAGRAM**, SET 24" in the ground.

From which,


A Fir 20" dia. Bears, S 40° E., 15.5 ft., scribed: C1/4 S5 BT

A Pine 18" dia. Bears, S55° W., 43.2 ft., scribed: C1/4 S5 BT

Measurements to trees taken with a metal tape and magnetic compass, with Declination set off 20 deg. East.

Nailed a brass washer stamped PLS 84B on blaze above BT scribe, Bearing Tree Sign above blaze, and warning sign on back of each tree. Painted a 6" red band at breast ht. around each tree. Set steel fence post with warning sign, South 5 ft. from the corner.

RECEIVED BY

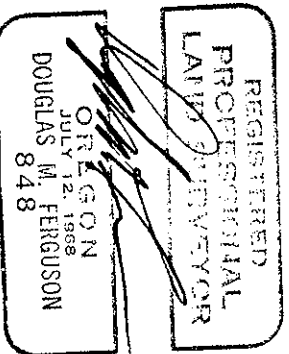

Morrow County Surveyor  
 Date 1-10-86  
 Rec'd by MJD  
 No. 732-K

Work by D.M. Ferguson, PLS 84B, Mt. Vernon Ore.  
 On Aug. 9, 1984  
 Witnessed by J. David Brinton, PLS 2065

Office of Surveyor County of MORROW

State of Oregon I hereby certify that the within instrument was filed in this office  
 for record on the 10 day of September, 1985

David H. Krambein by David Reynolds  
 (COUNTY OFFICIAL) (DEPUTY)