

CERTIFIED RECORD OF LAND CORNER MONUMENTATION

INDEX No. C-9

History of original corner establishment: Established in 1881, by Corner of originally established in 1881, by Edward W. Sanderson, under General Land Office Contract No. 417. Surveyor General's Notes State: (See official GLO Notes)

<b>DIAGRAM</b> on cap)
(TSS R28E)
1/4
1
55154
1
1938
GLO

In 1938 Leonard Carter, Cadastral Engineer for the "General Land Office" performed a Dependent Resurvey, Those Notes State: Proportionate measure set an iron post, 3 ft. long, 1 ins. diam., 28 ins. in the ground, for 1/4 sec. cor., with brass cap mkd. (See DIAGRAM) from which:  
A white fir, 15 ins. diam., bears N72°E., 33 lks. mkd. 1/4 S4 BT  
A white fir, 15 ins. diam., bears N 5°W., 68 lks. mkd. 1/4 S5 BT

Description of corner evidence found:

Found 1" iron pipe with 2-1/2" brass cap, stamped as shown on the **DIAGRAM**, set 8" above the ground.


Found Fir 22" dia., live, in good condition, as scribed in the 1938 Resurvey, with blaze healed over Bears record; N72°E., 21.8 ft.,

Found Fir 20" dia., live, in good condition as scribed in the 1938 Resurvey, with blaze healed over Bears record, N 5°W., 44.9 ft.,

Description of monument and accessories | established to perpetuate the original location of this corner:

Maintained Corner by setting a steel post with warning sign, North 2 ft. from the corner.

Maintained Accessories by nailing Bearing Tree signs above blazes and warning signs to the back of the original (1938) bearing trees and painting a 6" red band around each tree. Measurements to trees taken with a metal tape and magnetic compass, with Declination set off 20 deg. East.

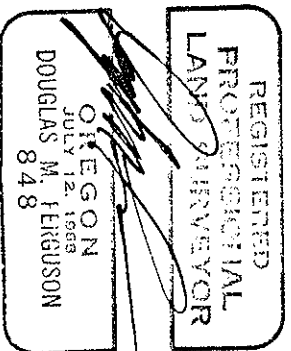

RECEIVED BY  
1-18-86  
Ladd & MUD  
748-K

Work by D.M. Ferguson, PLS 848, Mt. Vernon Ore.  
On Aug. 9, 1984  
Witnessed by J. David Brinton, PLS 2065

State of Oregon, I hereby certify that the within instrument was filed in this office for record on the 18<sup>th</sup> day of September 1985  
David H Krumbein by David Daymond  
(COUNTY OFFICIAL) (DEPUTY)