


CERTIFIED RECORD OF LAND CORNER MONUMENTATION

D-10

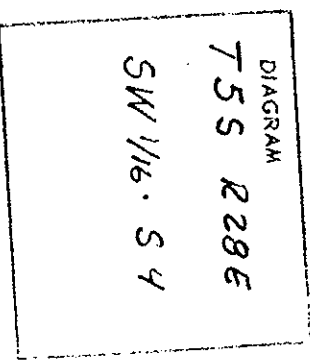

History of original corner establishment:

Unsurveyed - subdivided Section.

No record of subsequent remonumentation found in County Records.

Description of corner evidence found:

No evidence found.

I set the monument described below at the point of intersection of the four computed 1/16 corners of Section 4.

Description of monument and accessories I established to perpetuate the original location of this corner

At the position described above, I set a 2 1/2" x 30" iron pipe 24" in the ground, with a brass cap marked as shown:

From which I scribed BTS:

A lodge pine 12" in diam. bears N 57° W 7.7' marked SW 1/16 S 4 BT.  
A lodge pine 14" in diam. bears S 60° E 14.5' marked SW 1/16 S 4 BT.

I nailed a brass washer marked PLS 1638 to the BT blazes.  
I set a steel fence post 5' South and 5' East.


I painted a red band around the BTS and face of scribe.  
I used a steel tape and a magnetic compass with 21° East variation and measured a horizontal distance to the center of BTS.

This corner was set November 2, 1979.

Witness by Patrick L. Murphy and W. Keith Sands.

K. GIST, R.L.D.  
PROFESSIONAL  
LAND SURVEYOR

*Terry E. Hamby*  
OREGON  
JULY 14, 1978  
TERRY E. HAMBY  
1638

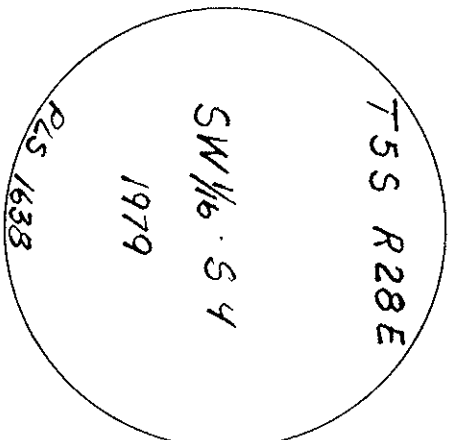

Office of \_\_\_\_\_ County Surveyor \_\_\_\_\_ Morrow

State of \_\_\_\_\_ Oregon, I hereby certify that the within instrument was filed in this office

for record on the \_\_\_\_\_ day of \_\_\_\_\_ Dec. 1979 by \_\_\_\_\_ (DEPUTY)

RECEIVED BY

Morrow County Surveyor

Date 10-10-79

Rec'd By *Wm J I*

No. 267-K