

CERTIFIED RECORD OF LAND CORNER MONUMENTATION

History of original corner establishments:

Index: D-11

Denver South 1/16 cor. secs. 4 & 9, T.55., R22E., W.M.	1	DIAGRAM	1
Original survey of township by Sanderson in 1881.	1		1
This corner not set.	1	T59 R22E	1
	1	C	1
Township retraced by Carter of GLO in 1938.	1	81/16 1 84	1
This corner not set.	1	C	1
	1	1979	1
	1	PLS 1638	1


This corner was set by PLS 1638 in 1979.
His record reads:

I set the monument described below at the midpoint between the found S 1/4 and the computed C 1/4 of Section 4. At the position described above, I set a 2 1/2" x 30" iron pipe 24" in the ground, with a brass cap marked as shown (see diagram) from which I scribed BT's:
A lodgepole pine 9" in diam. bears N30°W 17.11' marked OS1/1684BT.
A lodgepole pine 15" in diam. bears S88°E 19.11' marked OS1/1684BT.


Description of corner evidence found:
Found the iron pipe as described with brass cap stamped as shown in the diagram. From which:
A lodgepole pine stump bears N29°44'W, 17.8'.

Description of monument and accessories I established to perpetuate the original location of this corner:
The bearings were based on the surveyed bearing between the SW corner and the South 1/4 corner of section 4 as recorded in by PLS 1638 in Morrow County survey 257-K. I set the following new witness trees:
A 5" dbh White Fir bears N22°25'N, 22.51' scribed OS1/1684BT;
A 12" dbh White Fir bears S49°38'E, 10.21' scribed OS1/1684BT;
An aluminum washer stamped PLS 652 is nailed between the letters B and T on the new trees. All the BT's have LSM and BT signs attached.
Painted 6" red bands around all the trees and painted the scribble blazes red.

This work was done September 24, 1992.

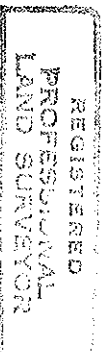

David L. Haddock

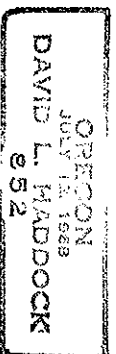

Office of _____ County of _____
State of _____, I hereby certify that the within instrument was filed
in this office for record on the _____ day of _____, 19____,
(COUNTY OFFICIAL) by _____ (DEPUTY)

FORM RS-7100-57 (9/71)

RECEIVED BY

Morrow County Surveyor

Date 11/92

Rec'd By WJG

No. _____