


CERTIFIED RECORD OF LAND CORNER MONUMENTATION

D-13

History of original corner establishment:

Unsurveyed - subdivided Section.

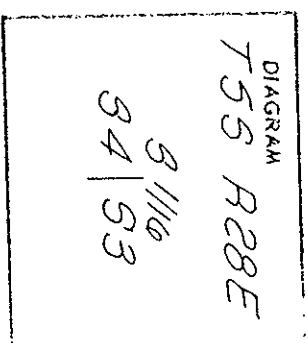

No record of subsequent remonumentation found in County Records.

Description of corner evidence found:

No evidence found.

I set the monument described below at the midpoint between the found W 1/4 and the SE corner of Section 3.

REGISTERED
PROFESSIONAL
LAND SURVEYOR

Terry E. Hamby
OREGON
JULY 14, 1978
TERRY E. HAMBY
1638

Description of monument and accessories established to perpetuate the original location of this corner

At the position described above, I set a 2 1/2" x 30" iron pipe 24" in the ground, with a brass cap marked as shown:

From which I scribed B's:

A fir 8" in diam. bears S 65° W 15.0' marked S 1/16 S 4 T 5S R 28E BT.
A fir 10" in diam. bears S 43° E 15.2' marked S 1/16 S 3 T 5S R 28E BT.

I nailed a brass washer marked PLS 1638 to the BT blazes.


I set a steel fence post 5' North and 7' East with signs.

I painted a red band around the B's and face of scribe.

I used a steel tape and a magnetic compass with 21° East variation and measured a horizontal distance to the center of B's.

This corner was set October 30, 1979.

Witness by W. Keith Sands.

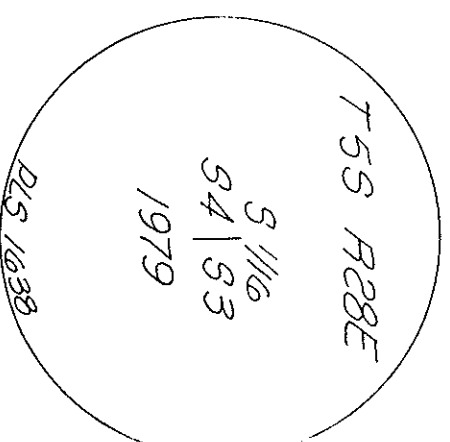

Office of _____ County Surveyor _____ Morrow _____

State of Oregon, I hereby certify that the within instrument was filed in this office

for record on the _____ day of _____, 1979

_____ by _____ (DEPUTY)

RECEIVED BY

Morrow County Surveyor

Date 12-10-79

Rec'd By MXTI

No. 266-K

OSMA Open during showing

#266-K