


CERTIFIED RECORD OF LAND CORNER MONUMENTATION

D-15

History of original corner establishment:

Unsurveyed - subdivided Section.

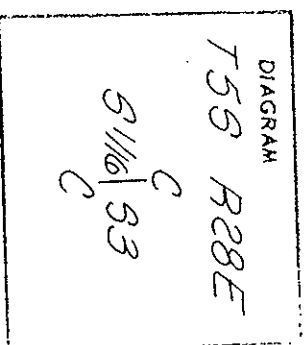

No record of subsequent remonumentation found in County Records.

Description of corner evidence found:

No evidence found.

I set the monument described below at the midpoint between the found S 1/4 and computed C 1/2 of Section 3.

REGISTERED
PROFESSIONAL
LAND SURVEYOR

Terry E. Hamby
OREGON
JULY 14, 1978
TERRY E. HAMBY
1638

Description of monument and accessories established to perpetuate the original location of this corner

At the position described above, I set a 2 1/2" x 30" iron pipe 26" in the ground, with a brass cap marked as shown:

From which I scribed BTs:

A lodge pine 10" in diam. bears N 02° E 14.5' marked CS 1/16 S 3 BT with signs.
A lodge pine 13" in diam. bears S 61° E 13.9' marked CS 1/16 S 3 BT with signs.

I nailed a brass washer marked PLS 1638 to the BT blazes.


I set a steel fence post 5' North and 5' West with signs.

I painted a red band around the BTs and face of scribe.

I used a steel tape and a magnetic compass with 21° East variation and measured a horizontal distance to the center of BTs.

This corner was set November 1, 1979.

Witness by W. Keith Sands and Jerry I. Ogawa.

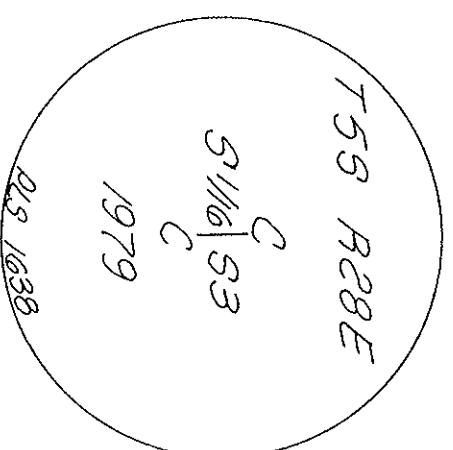

Office of County Surveyor Morrow RECEIVED BY

State of Oregon, I hereby certify that the within instrument was filed in this office, Morrow County Surveyor

for record on the 4 day of Dec 1979. Date 12-10-79

by *Darryl H. Klein* (DEPUTY) Red'd By *WJJS*

Mo. 366-K

CDP 798
CORRECTION DRAWING