


CERTIFIED RECORD OF LAND CORNER MONUMENTATION

INDEX No. 1)-7
History of original corner establishment:

Corner not previously established.

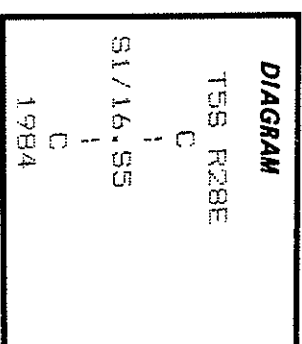


Description of corner evidence found:

Corner not previously established.

Description of monument and accessories | established to perpetuate the original location of this corner:

Set 2-1/2"x30" aluminum pipe with 2-1/2" aluminum cap, stamped as shown on the **DIAGRAM**, SET 20" in the ground.
From Which.
A Fir 12" dia. Bears, N23°W., 21.2 ft., scribed: C-S 1/16 SS RT
A Fir 12' dia. Bears, N51°E., 23.9 ft., scribed: C-S 1/16 SS RT
Measurements to trees taken with a metal tape and magnetic compass, with Declination set off 20 deg. East.
Nailed a brass washer stamped PLS 848 on blaze above RT scribe, Bearing Tree Sign above blaze, and warning sign on back of each tree. Painted a 6" red band at breast ht. around each tree. Set steel fence posts with warning & Boundary Signs, East & West, 5 ft. from the corner.

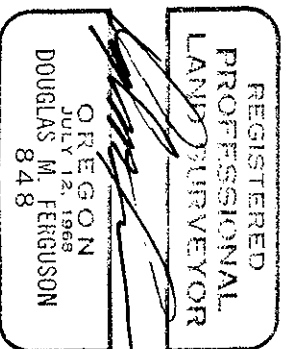

RECEIVED BY
Morrow County Surveyor
Date 1-10-86
Recd. by MVD
No. 733-K

Work by D.M. Ferguson, PLS 848, Mt. Vernon Ore
On Aug. 6, 1984
Witnessed by J. David Brinton, PLS 2065

Office of SUNNYGOS County of MORROW
State of OREGON I hereby certify that the within instrument was filed in this office
for record on the 10TH day of September, 1985
by David H. Krumbein by Brent Reynolds
(COUNTY OFFICIAL) (DEPUTY)