

CERTIFIED RECORD OF LAND CORNER MONUMENTATION

INDEX No. D-8

History of original corner establishment:

Corner not previously established.

<b>DIAGRAM</b>
T55 R28E
SE 1/16
SS
1984
PLS 848

Description of corner evidence found:

Corner not previously established.

Description of monument and accessories | established to perpetuate the


original location of this corner:

Set 2-1/2"x30" aluminum pipe with 2-1/2" aluminum cap, stamped as shown on the DIAGRAM, SET 26" in the ground.

From which.

A Fir 10" dia. Bears, N70<sup>0</sup>W., 9.6 ft., scribed: SE 1/16 SS BT  
A Fir 8" dia. Bears, S57<sup>0</sup>E., 9.5 ft., scribed: SE 1/16 SS BT  
Measurements to trees taken with a metal tape and magnetic compass, with Declination set of 20 deg. East.

Nailed a brass washer stamped PLS 848 on blaze above BT scribe, Bearing Tree Sign above blaze, and warning sign on back of each tree. Painted a 6" red band at breast ht. around each tree. Set steel fence posts with warning & Boundary Signs, South & West 5 ft. from the corner.

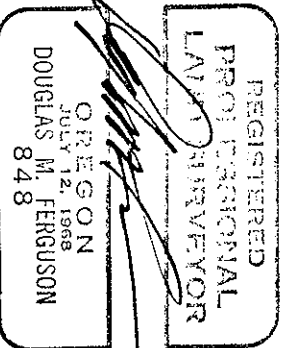

RECEIVED BY  
Morrow County Surveyor  
Date 1-10-86  
Incd. by MUD  
No. 745-K

Work by D.M. Ferguson, PLS 848, Mt. Vernon Ore.  
On Aug. 6, 1984  
Witnessed by J. David Brinton, PLS 2065

10

Office of Sweeney County of MORROW  
 State of OREGON, I hereby certify that the within instrument was filed in this office  
 for record on the 10<sup>th</sup> day of September, 1985  
 by David H Krambein by David Dwyer  
 (COUNTY OFFICIAL) (DEPUTY)