


CERTIFIED RECORD OF LAND CORNER MONUMENTATION

E-10

History of original corner establishment:

Unsurveyed - subdivided Section.

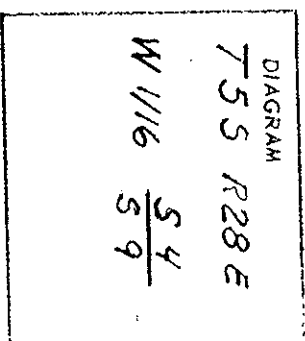

No record of subsequent remonumentation found in County Records.

Description of corner evidence found:

No evidence found.

I set the monument described below at the midpoint between the found N 1/4 and the NW corner of Section 15.

Description of monument and accessories I established to perpetuate the original location of this corner

At the position described above, I set a 2 1/2" x 30" iron pipe 24" in the ground, with a brass cap marked as shown:

From which I scribed BTs:

A lodgepole pine 12" in diam. bears N 77° W 43.6' marked W 1/16 S 4 T 5 S 4 28E BT.
A lodgepole pine 12" in diam. bears N 06° E 8.3' marked W 1/16 S 4 T 5 S R 28E BT.

I nailed a brass washer marked PLS 1638 to the BT blazes.

I set a steel fence post 5' North and 5' West with signs.

I painted a red band around the BTs and face of scribe.

I used a steel tape and a magnetic compass with 21° East variation and measured a horizontal distance to the center of BTs.


This corner was set October 22, 1979.

Witness by Roderick D. Purches and Dennis L. Paasch.

K. GISTERED
PROFESSIONAL
LAND SURVEYOR

Terry E. Hamby

OREGON
JULY 14, 1978
TERRY E. HAMBY
1638

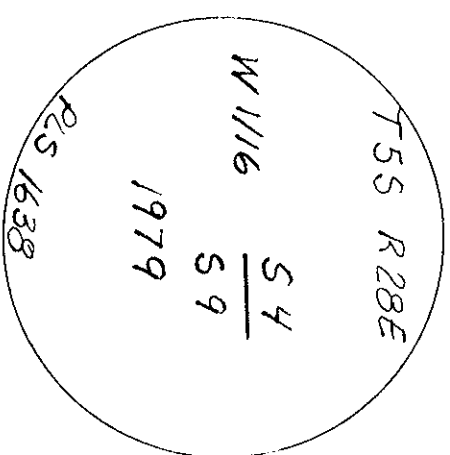

Office of _____ County Surveyor _____ County of _____ MORROW

State of _____ Oregon _____, I hereby certify that the within instrument was filed in this office

for record on the _____ day of _____ Dec. 1979

David H. Klein (COUNTY OFFICIAL) by _____ (DEPUTY)

RECEIVED BY

Morrow County Surveyor

Date 10-10-79

Rec'd By WMS

No. 267-K

Corresponding drawing