

CERTIFIED RECORD OF LAND CORNER MONUMENTATION

History of original corner establishment:

Index: E-10

West 1/16 cor. secs. 4 & 5, T.55S., R.22E., W.M.

Original survey of township by Sanderson in 1881.  
This corner not set.

Township retraced by Carter of GLO in 1938.  
This corner not set.

This corner was set by PLS 1638 in 1979.

His record reads:

I set the monument described below at the midpoint between the found N 1/4 and the NW corner of Section 15. At the position described above, I set a 2 1/2" x 30" iron pipe 24" in the ground, with a brass cap marked as shown: (see diagram) from which I scribed BT's:

A lodgepole pine 12" in diam, bears N77°W (3.6') marked M1/1684T55428E8T.  
A lodgepole pine 12" in diam, bears N06°E (8.3') marked M1/1684T55828E8T.

Description of corner evidence found:


Found the iron pipe as described with brass cap stamped as shown in the diagram. The monument was at a joint, as indicated by an unclosed survey, which is 0.107 north and 0.087 east of the midpoint between the N 1/4 and the NW corner of section 9. From which:

A 16" dbh lodgepole pine stump bears N5°39'E, 8.6' with scribe splinter.


Description of monument and accessories I established to perpetuate the original location of this corner:

The bearings were based on the surveyed bearing between the SW corner and the South 1/4 corner of section 4 as recorded in by PLS 1638 in Morrow County survey 267-K. I set the following new witness trees:  
A 15" dbh Tamarack bears N3°21'W, 18.8', scribed M1/1684BT;  
A 8" dbh Engelman Spruce bears 383°40'W, 35.1', scribed M1/1689BT;  
An aluminum washer stamped PLS 852 is nailed between the letters B and T on the new trees. All the BT's have LSM and BT signs attached. Painted 6" red bands around all the trees and painted the scribe bases red.

This work was done September 24, 1992.

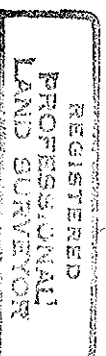

*David L. Hadlock*

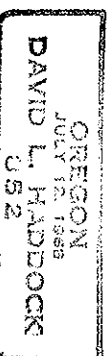

Office of \_\_\_\_\_, County of \_\_\_\_\_  
State of \_\_\_\_\_, I hereby certify that the within instrument was filed  
in this office for record on the \_\_\_\_\_ day of \_\_\_\_\_, 19\_\_\_\_.

\_\_\_\_\_ by \_\_\_\_\_  
( COUNTY OFFICIAL ) ( DEPUTY )

Form RS-7100-57 (9/71)

RECEIVED BY

Morrow County Surveyor

Date 11/92

Rec'd By KO

No. \_\_\_\_\_