

CERTIFIED RECORD OF LAND CORNER MONUMENTATION


E-19

History of original corner establishment:

E.W. Sanderson under G.L.O. contract no. 417, dated Aug. 24, 1881, set a sandstone 14"x 7"x 6", 9" in the ground. Stone marked $\frac{1}{4}$ on N. face. From Cor.:
 A Fir, 24" dia., N30E, 25 lks.
 A Fir, 15" dia., S250W, 31 lks.

Leonard Gärter, Public Land Surveyor, under G.L.O. special instructions, Group No. 228, dated Mar. 23, 1938, did not find the Sanderson corner. At proportionate distance he set a 1"x 36" iron post with a brass cap marked:

From the corner:
 A Tamarack, 35" dia., N350W, 60 lks. $\frac{1}{4}$ $\frac{52}{511}$
 A Tamarack, 45" dia., South, 44 lks. 1939

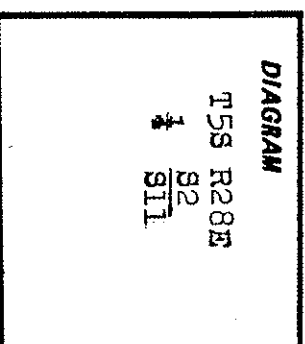

Description of corner evidence found:

A 1" iron pipe with a 2 $\frac{1}{2}$ " brass cap (G.L.O.) marked: $\frac{1}{4}$ $\frac{52}{511}$ 1939

From the corner:

A Western Larch stump, 46" dia., South, 29.0 ft.; with a healed blaze.
 A Western Larch snag, 36" dia., N350W, 39.6 ft.; with scribing visible.

Description of monument and accessories | established to perpetuate the

original location of this corner:

I built a mound of stone around the monument and marked new BTs:

A Spruce, 12" dia., S840E, 39.1 ft.; marked: $\frac{1}{4}$ 511 BT
 A Spruce, 12" dia., N500E, 56.3 ft.; marked: $\frac{1}{4}$ 52 BT

BTs have blaze and a 6" band painted red, BT tags and "Land Survey Monument" signs. New BTs have, additionally, alum. "PLS 1832" washers nailed to the bottom of the blaze. There is a 6' steel fence post with a "Land Survey Monument" sign within 5' of the corner.

Measured to center of BTs using steel tape and staff compass. Magnetic declination set at 190E.

September 14, 1988


RECEIVED BY

Morrow County Surveyor

Date 11/1988

Rec'd By 1988

No. C 8721k

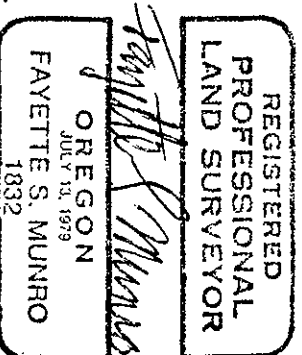

REGISTERED
 PROFESSIONAL
 LAND SURVEYOR
 OREGON
 JULY 13, 1979
 FAYETTE S. MUNRO
 1832

Office of..... County of.....

State of....., I hereby certify that the within instrument was filed in this office

for record on the..... day of....., 19.....

..... by (DEPUTY)

(COUNTY OFFICIAL)