


History of original corner establishment:

E.W. Sanderson under G.L.O. contract no. 417, dated Aug. 24, 1881, set a post 4" square and 4' long 24" in the ground. From the corner:
A Black Pine, 8" dia., S60°E, 34 lks.
A Black Pine, 10" dia., S87°W, 20 lks.
A Black Pine, 14" dia., N60°W, 13 lks.
A Black Pine, 8" dia., N55°E, 19 lks.

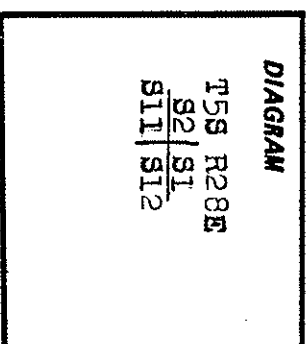

Leonard Carter, Public Land Surveyor, under G.L.O. special instructions, Group No. 228, dated Mar. 23, 1938, located the corner point from the one surviving BT and set an iron post 2" x 3' with a brass cap marked:

From the corner:
A Lodgepole pine, 6" dia., dead and down, S50°E, 34 lks.
(Continued on Page 2 of 2.)

T55 R28E
S2/S1
S11/S12
1938

Description of corner evidence found:

I found a 2" iron pipe with a 2 1/2" brass cap (G.L.O.) marked:

T55 R28E
S2/S1
S11/S12
1938

From the corner:

A Western Larch snag, 18" dia., N70°E, 32.5 ft.; with scribbling visible.
A White Fir snag, 20" dia., S61°E, 38.3 ft.; with a healed blaze.
A White Fir snag, 13" dia., S11°W, 35.0 ft.; with scribbling visible.
A Spruce, 18" dia., N25°W, 11.9 ft.; with a healed blaze.

Description of monument and accessories established to perpetuate the

original location of this corner:

I marked new BTs:
A Spruce, 20" dia., N18°E, 121.2 ft.; marked: T55 R28E S1 BT
A Spruce, 11" dia., S74°W, 121.9 ft.; marked: T55 R28E S11 BT

Reference Monument:
I drove a 5/8" x 30" iron rod (rebar) 25" in the ground; S20 1/2°E, 8.3 ft.; with a 1 1/8" yellow plastic cap marked: PLS 1832

BTs have blaze and a 6" band painted red, BT tags and "Land Survey Monument" signs. New BTs have, additionally, alum. "PLS 1832" washers nailed to the bottom of the blaze. There is a 6' steel fence post with a "Land Survey Monument" sign within 5' of the corner.

Measured to center of BTs using steel tape and staff compass. Magnetic declination set at 18°E.

September 14, 1988

REGISTERED
PROFESSIONAL
LAND SURVEYOR

RECEIVED BY
Morrow County Surveyor

Fayette S. Munro

Date 11/188
Rec'd by LOAK
No. C 272K
OREGON
JULY 13, 1979
FAYETTE S. MUNRO
1832

Office of..... County of.....
State of..... I hereby certify that the within instrument was filed in this office
for record on the..... day of..... 19.....
..... by.....
..... (DEPUTY)