


History of original corner establishment:  
(Continued from Page 1 of 2.)


Corner marked new BTs:

- A Tamarack, 19" dia., N70°E, 50 lks.
- A White Fir, 12" dia., S61°E, 58 lks.
- A White Fir, 10" dia., S11°W, 53 lks.
- A Spruce, 13" dia., N25°W, 18 lks.

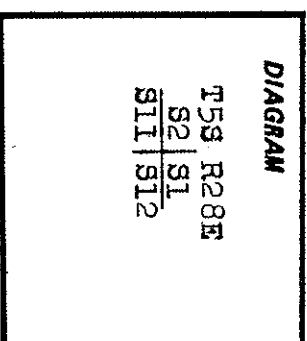

Description of corner evidence found:

Description of monument and accessories | established to perpetuate the original location of this corner:

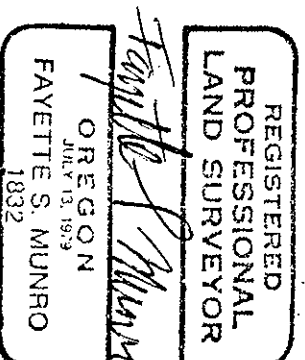

Office of..... County of.....  
State of....., I hereby certify that the within instrument was filed in this office  
for record on the..... day of....., 19.....

(COUNTY OFFICIAL)

RECEIVED BY

(DEPUTY)

Form R6-7100-57 (9/71)

Morrow County Surveyor

Date 11/88

Rec'd By DHK

No. 08724