

CERTIFIED RECORD OF LAND CORNER MONUMENTATION

INDEX No. E.25-1

E-1 by J.E. Cousins

History of original corner establishment:

DIAGRAM

*E-01 1
R 25E
Line TREE*

This line tree was originally established by Edward W. Sanderson in 1881-82 under GLO Contract Number 417. Surveyor General Field Notes state:

T55
R27E R28E
Line Tree
WC

74.80 A Fir 36 in. dia on ridge bears SE 400

S12 ~~7~~ 5 7 ft
1992
PLS 848

Description of Corner Evidence Found:


At near record position south of Sec. Cor. 1,6,7,12 I found the rotten remains of a Fir stump over 36" in dia. I tied this stump into my traverse and found it fit very well, and I accept it as the remains of the L.T.

Description of monument and accessories I established to perpetuate the original location of this corner:

At a point 10.0 ft. north, on line, I set 2-1/2"x30" aluminum pipe with 3-1/2" aluminum cap, stamped as shown on the DIAGRAM, 26" in the ground for the witness corner to the line tree. The new BT's are to the line tree:

Ponderosa Pine, 24" Dia., bears N34°45'W, 138.2 ft., scribed: LT S12 BT
Douglas Fir, 10" Dia., bears N73°30'E, 49.0 ft., scribed: LT S 7 BT

Measurements to BT's taken with a magnetic compass, declination 20° East, and a nylon clad steel tape. Set steel fence post with Land Survey Monument (54-9) and Property Boundary (54-2) signs 5' north of the monument. Nailed a brass washer stamped PLS 848 on blaze above BT scribe as taken this survey. Nailed Bearing Tree (54-3) signs above blaze and Land Survey Monument (54-9) signs on back of each tree as required. Painted a 6" red band above Bearing Trees signs and painted blaze red.

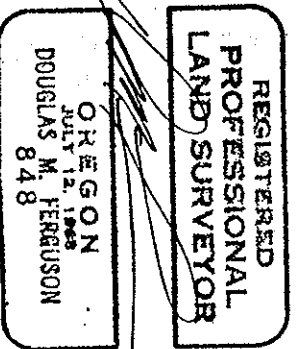

This work was performed by:
Douglas M. Ferguson PLS 848
Witnessed by: D. Mitchell Ferguson
and Rick Saul
April 21, 1992
Refer to Morrow Co. Survey No.: C-938-E

Office of OR I hereby certify that the within instrument was filed in this office for record on the 9 day of July, 1992
County of MORROW
by SB
(COUNTY OFFICIAL) (DEPUTY)